

SEP 01 1998

SECTION REMONUMENTATION

LIBER

2 PAGE 194

RECEIVED FOR RECORD

LAND CORNER RECORDATION CERTIFICATE
Filing Requirement of Act 74, Mich. P.A. 1970

98 JUN 30 AM 10: 21

LIBER NO. 2 PAGE NO. 194

MICHELE VANNORMAN
REGISTER OF DEEDS
SANILAC CO., MICHIGAN

For corners in
Sanilac

(County)

Located In:

Corner Code #

- 1. Public Land Survey T 13NR 12E A-5
T R
T R
T R
- 2. Property Controlling in Section S T R
S T R
- 3. Miscellaneous Property in Sec. S T R
S T R

Register of Deeds Stamp & File Number

- 4. Lot No. _____, Recorded Plat _____
- 5. Private Claims _____

I, John A. Milletics, in a field survey on May 1, 1998 do hereby state that under requirements of P.A. 74, Michigan P.A. of 1970, the corner points mentioned in lines 1 and 2 above were in conformance with regulations and rules therefore as required in the current manual of survey instructions of the United States Department of the Interior, Bureau of Land Management or by a decree of a Court of Law and /or that the corner points mentioned in lines 3, 4 and 5 above were in conformance with the rules of the Michigan Board of Land Surveyors or by a Decree of a Court of Law; established, re-established, monumented, recovered, found as expressed below:

NOTE: Not more than 2 corners, all in the same town and range, may be recorded on this certificate.

	A	B	C	D	E	F	G	H	I	J	K	L
1												
2	6		5		4		3		2		1	
3												
4	7		8		9		10		11		12	
5												
6	18		17		16		15		14		13	
7												
8	19		20		21		22		23		24	
9												
10	30		29		28		27		26		25	
11												
12	31		32		33		34		35		36	
13												

A. Description of original monument and accessories and/or subsequent restoration:

1834 GLO Notes-Harvey Parke, D.S.-Set post Cor. Secs. 12 & 13-Hemlock 16 N15W 4 1/2; Birch 14 S23W 16 1/2

Old Survey Liber F.F. Rogers
Act 132 James A. Beck

B. Description of corner evidence found and/or method applied in restoring or reestablishing corner:


A-5
Found Concrete Monument with Brass Cap
North 2642.41 to the W 1/4 Corner Section 7
South 2634.97 to the W 1/4 Corner Section 18

APPROVED PEER BOARD MEETING
June 6, 1998 *gm*

C. Description of monument for corner and accessories established to perpetuate locating the position of the

A-5

Concrete monument with 2" Brass Cap stamped M5 T13N-R11E
N65°E, 75.45'-T.C. Re-mon. tag in Southeast face of 16" White Pine
N74°E, 68.10'-T.C. Re-mon. tag in Northwest face of 18" White Pine
S30°E, 55.15'-T.C. Re-mon. tag in Southwest face of 8" Elm
N65°W, 45.66'-Punch mark: in top of pipe cap at top of gate post
N15°W, 67.61'-T.C. Re-mon. tag above found nail in East face of 18" Multi-trunk Cherry

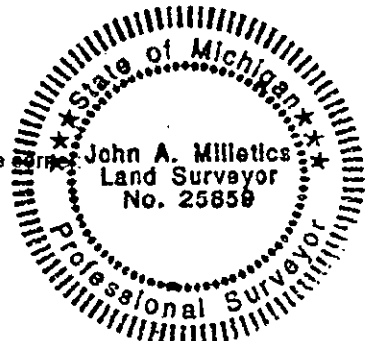

Signed by John A. Milletics
Surveyor's Michigan License No. 25859

Date May 10, 1998