

SURVEY & REMONUMENTATION

SEP 01 1998

SECTION REMONUMENTATION

LIBER 2 PAGE 196

RECEIVED FOR RECORD

LAND CORNER RECORDATION CERTIFICATE Filing Requirement of Act 74, Mich. P.A. 1970

98 JUN 30 AM 10: 21

LIBER NO. 2 PAGE NO. 196

For corners in

<u>Sanilac</u> (County)	Located in:	Corner Code #
1. Public Land Survey	T <u>13</u> N R <u>12</u> E	<u>A-7</u>
	T ___ R ___	_____
	T ___ R ___	_____
	T ___ R ___	_____
2. Property Controlling in Section	S ___ T ___ R ___	_____
	S ___ T ___ R ___	_____
3. Miscellaneous Property in Sec.	S ___ T ___ R ___	_____
	S ___ T ___ R ___	_____

MICHELE VANNORMAN REGISTER OF DEEDS SANILAC CO., MICHIGAN

Register of Deeds Stamp & File Number

4. Lot No. _____, Recorded Plat _____
5. Private Claims _____

I, John A. Milletics, in a field survey on May 1, 19 98 do hereby state that under requirements of P.A. 74, Michigan P.A. of 1970, the corner points mentioned in lines 1 and 2 above were in conformance with regulations and rules therefore as required in the current manual of survey instructions of the United States Department of the Interior, Bureau of Land Management or by a decree of a Court of Law and /or that the corner points mentioned in lines 3, 4 and 5 above were in conformance with the rules of the Michigan Board of Land Surveyors or by a Decree of a Court of Law; established, re-established, monumented, recovered, found as expressed below:

NOTE: Not more than 2 corners, all in the same town and range, may be recorded on this certificate.

A	B	C	D	E	F	G	H	I	J	K	L	I
1												
2	6	5	4	3	2	1						
3												
4	7	8	9	10	11	12						
5												
6	16	17	16	15	14	13						
7												
8	19	20	21	22	23	24						
9												
10	30	29	28	27	26	25						
11												
12	31	32	33	34	35	36						
13												

A. Description of original monument and accessories and/or subsequent restoration:

1834 GLO Notes-Harvey Parke, D.S.-Set post cor. Secs. 13 & 14-Hemlock 8 N41W 22; Hemlock 10 S14W 22

Old Survey Liber F.F. Rogers
Old Survey Liber M.E Ward
Act 132 James A. Beck
Liber 3 Page 322-323


B. Description of corner evidence found and/or method applied in restoring or reestablishing corner:

A-7
Found Concrete Monument with Brass Cap
North W 1/4 Corner Section 18
South W 1/4 Corner Section 19

APPROVED PEER BOARD MEETING
June 6, 1998

C. Description of monument for corner and accessories established to perpetuate locating the position of the corner:

A-7
Concrete Monument with 2" Brass Cap stamped M7 T13N-R11E.
S60°E, 73.15' -T.C. Re-mon. tag in Northeast face of 30" Maple
S18°E, 67.50' -T.C. Re-mon tag in Southwest face of 5" Maple
S45°W, 74.53' -T.C. Re-mon. tag above found tag 11192 in Southeast face of Power Pole
N50°W, 29.90' -Set 1/2" Diameter reinforcing rod

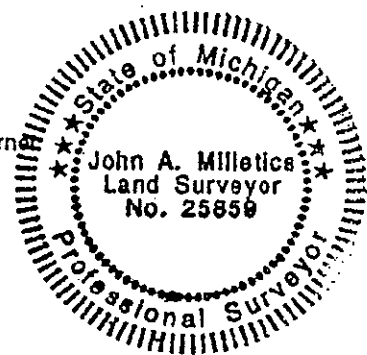

Signed by John A. Milletics
Surveyor's Michigan License No. 25859

Date May 10, 1998