

SEP 01 1998

SECTION REMONUMENTATION

LIBER 2 PAGE 197

RECEIVED FOR RECORD

LAND CORNER RECORDATION CERTIFICATE 98 JUN 30 AM 10:21 Filing Requirement of Act 74, Mich. P.A. 1970 LIBER NO. 2 PAGE NO. 197

For corners in

Sanilac (County)	Located In:	Corner Code #
1. Public Land Survey	T13N R12E	A-8
	T R	
	T R	
	T R	
	T R	
2. Property Controlling in Section	S T R	
	S T R	
3. Miscellaneous Property in Sec.	S T R	
	S T R	

MICHELE VANNORMAN REGISTER OF DEEDS SANILAC CO., MICHIGAN

Register of Deeds Stamp & File Number

4. Lot No. , Recorded Plat 5. Private Claims

John A. Milletics, in a field survey on May 1, 1998 do hereby state that under requirements of P.A. 74, Michigan P.A. of 1970, the corner points mentioned in lines 1 and 2 above were in conformance with regulations and rules therefore as required in the current manual of survey instructions of the United States Department of the Interior, Bureau of Land Management or by a decree of a Court of Law and/or that the corner points mentioned in lines 3, 4 and 5 above were in conformance with the rules of the Michigan Board of Land Surveyors or by a Decree of a Court of Law; established, re-established, monumented, recovered, found as expressed below:

NOTE: Not more than 2 corners, all in the same town and range, may be recorded on this certificate.

1	A	B	C	D	E	F	G	H	I	J	K	L	M
2		6		5		4		3		2		1	
3													
4		7		8		9		10		11		12	
5													
6		10		17		16		15		14		13	
7													
8		19		20		21		22		23		24	
9													
10		30		29		28		27		26		25	
11													
12		31		32		33		34		35		36	
13													

A. Description of original monument and accessories and/or subsequent restoration:

1834 GLO Notes-Harvey Parke, D.S.-Set 1/4 Sec.Post-Surgar 20 S49W 20: Hemlock 6 N28W 57 1/2 Old Survey Liber F.F. Rogers Old Survey Liber M.E. Ward Liber 2 Page 130-131


B. Description of corner evidence found and/or method applied in restoring or reestablishing corner:

A-8 Found Concrete Monument with Brass Cap North 2644.34 Feet to the NW Corner Section 19 South 2651.09 Feet to the SW Corner Section 19

APPROVED PEER BOARD MEETING June 6 1998

C. Description of monument for corner and accessories established to perpetuate locating the position of the corner:

A-8 Concrete Monument with 2" Brass Cap stamped M8 T13N-R11E N82°E, 40.40'-T.C. Re-mon. tag in South face of 6" Twin Elm S40°E, 50.99'-T.C. Re-mon tag in Southwest face of 7" Locust S24°W, 46.57'-T.C. Re-mon. tag in Northwest face of 5" Ash West 85.28'-T.C. Re-mon. tag in North face of Power Pole (also found tag 11192 in East face)

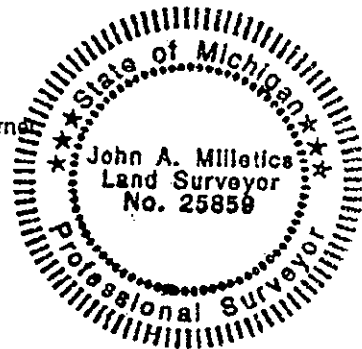

Signed by John A. Milletics Surveyor's Michigan License No. 25859

Date May 10, 1998