

SEP 01 1998

SECTION REMONUMENTATION

LIBER

2 PAGE 199

RECEIVED FOR RECORD

LAND CORNER RECORDATION CERTIFICATE Filing Requirement of Act 74, Mich. P.A. 1970

98 JUN 30 AM 10:21

LIBER NO. 2 PAGE NO. 199

MICHELE VANNORMAN REGISTER OF DEEDS SANILAC CO., MICHIGAN

For corners in

Sanilac (County)

Located In:

Corner Code #

- 1. Public Land Survey T13N R12E A-10
2. Property Controlling in Section S T R
3. Miscellaneous Property in Sec. S T R

Register of Deeds Stamp & File Number

4. Lot No. , Recorded Plat
5. Private Claims

John A. Milletics, in a field survey on May 1, 1998 do hereby state that under requirements of P.A. 74, Michigan P.A. of 1970, the corner points mentioned in lines 1 and 2 above were in conformance with regulations and rules therefore as required in the current manual of survey instructions of the United States Department of the Interior, Bureau of Land Management or by a decree of a Court of Law and/or that the corner points mentioned in lines 3, 4 and 5 above were in conformance with the rules of the Michigan Board of Land Surveyors or by a Decree of a Court of Law; established, re-established, monumented, recovered, found as expressed below:

NOTE: Not more than 2 corners, all in the same town and range, may be recorded on this certificate.

Grid table with columns A-L and rows 1-13. Contains numbers 6-36 in a grid pattern.

A. Description of original monument and accessories and/or subsequent restoration:

1834 GLO Notes-Harvey Parke, D.S. -Set 1/4 Sec. post-Beech 15' N10W 26 1/2; Hemlock 15 S4W 24

Old Survey Liber F.F. Rogers Act 132 Liber 4 Page 691&692


B. Description of corner evidence found and/or method applied in restoring or reestablishing corner:

A-10 Found Concrete Monument with brass Cap North to the NW Corner Section 30 South to the SW Corner Section 30

APPROVED PEER BOARD MEETING June 16, 1998

C. Description of monument for corner and accessories established to perpetuate locating the position of the corner:

A-10 Concrete Monument with 2" Brass Cap stamped M10 T13-R11E S82°E, 28.55'-T.C. Re-mon. tag in South face of 30" Maple S45°, 36.70' -T.C. Re-mon. tag in Southwest face of 28" Maple S16°W, 94.31'-T.C. Re-mon. tag in Northwest face of 7" Ash West, 56.00' -T.C. Re-mon. tag in North Face of Power Pole(also nail in East face of pole)

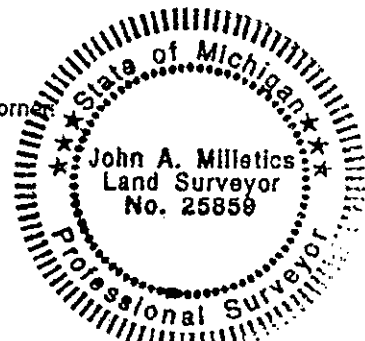

Signed by John A. Milletics Surveyor's Michigan License No. 25859

Date May 10, 1998