

SEP 01 1998

SECTION REMONUMENTATION

LIBER 2 PAGE 201

RECEIVED FOR RECORD

LAND CORNER RECORDATION CERTIFICATE  
Filing Requirement of Act 74, Mich. P.A. 1970

98 JUN 30 AM 10:21

LIBER NO. 2 PAGE NO. 201

For corners in

<u>Sanilac</u> (County)	Located In:	Corner Code #
1. Public Land Survey	T <u>13</u> NR <u>12</u> E	A-12
	T ___ R ___	_____
	T ___ R ___	_____
	T ___ R ___	_____
2. Property Controlling in Section	S ___ T ___ R ___	_____
	S ___ T ___ R ___	_____
3. Miscellaneous Property in Sec.	S ___ T ___ R ___	_____
	S ___ T ___ R ___	_____

MICHELE VAN NORMAN  
REGISTER OF DEEDS  
SANILAC CO., MICHIGAN

Register of Deeds Stamp & File Number

4. Lot No. \_\_\_\_\_, Recorded Plat \_\_\_\_\_  
5. Private Claims \_\_\_\_\_

I, John A. Milletics, in a field survey on May 1, 19 98 do hereby state that under requirements of P.A. 74, Michigan P.A. of 1970, the corner points mentioned in lines 1 and 2 above were in conformance with regulations and rules therefore as required in the current manual of survey instructions of the United States Department of the Interior, Bureau of Land Management or by a decree of a Court of Law and /or that the corner points mentioned in lines 3, 4 and 5 above were in conformance with the rules of the Michigan Board of Land Surveyors or by a Decree of a Court of Law; established, re-established, monumented, recovered, found as expressed below:

NOTE: Not more than 2 corners, all in the same town and range, may be recorded on this certificate.

A	B	C	D	E	F	G	H	I	J	K	L	M
1												
2	6		5		4		3		2		1	
3												
4	7		8		9		10		11		12	
5												
6	18		17		16		15		14		13	
7												
8	19		20		21		22		23		24	
9												
10	30		29		28		27		26		25	
11												
12	31		32		33		34		35		36	
13												

A. Description of original monument and accessories and/or subsequent restoration:

1834 GLO Notes-Harvey Parke, D.S.-Set 1/4 sec. post-Hemlock 8 N17W 23; Hemlock 5 S65W12

Old Survey Liber : Dated 1889 F.F. Rogers

B. Description of corner evidence found and/or method applied in restoring or reestablishing corner:

A-12


Found Concrete Monument with Brass Cap  
North 2638.80 To the NW corner Section 31  
South 2638.80 to the SW Corner Section 31

APPROVED PEER BOARD MEETING  
June 6, 1998

C. Description of monument for corner and accessories established to perpetuate locating the position of the corner:

A-12

Concrete Monument with 2" Brass Cap stamped M12 T13N-R11E  
N62°E, 47.58'-T.C. Re-mon. tag in Southeast face of 10" Apple  
S30°E, 52.73'-T.C. Re-mon. tag in Southwest face of 5" Elm  
S18°W, 22.66'-Set. 1/2" Reinforcing rod  
N43°W. 17.12'- Set 1/2" Reinforcing rod

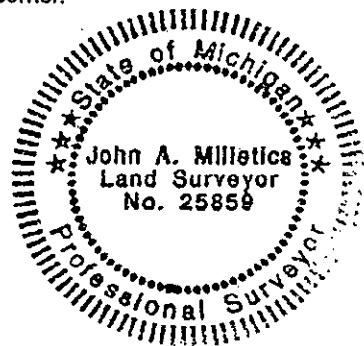

Signed by John A. Milletics  
Surveyor's Michigan License No. 25859

Date May 10, 1998