

APR 14 1998

LIBER 2 PAGE 156

SECTION

1997 REMONUMENTATION
LAND CORNER RECORDATION CERTIFICATE
Filing Requirement of Act 74, Mich. P.A. 1970

RECEIVED FOR RECORD
97 DEC -2 AM 9:09
LIBER NO. 2 PAGE NO. 156
ESTHER LEE
REGISTER OF DEEDS
SANILAC CO., MICHIGAN

SURVEY & REMONUMENTATION

JAN 08 1998

SECTION
Register of Deeds Stamp & File Number

For corners in EVERGREEN TOWNSHIP

SANILAC (County)	Located In:	Corner Code #
1. Public Land Survey	T13NR12E	K5
	T13NR12E	L5
	T R	
	T R	
2. Property Controlling in Section	S T R	
	S T R	
3. Miscellaneous Property in Sec.	S T R	
	S T R	

4. Lot No. _____, Recorded Plat _____
5. Private Claims _____

I, John A. Millettics, in a field survey on Oct. 26, 1997, do hereby state that under requirements of P.A. 74, Michigan P.A. of 1970, the corner points mentioned in lines 1 and 2 above were in conformance with regulations and rules therefore as required in the current manual of survey instructions of the United States Department of the Interior, Bureau of Land Management or by a decree of a Court of Law and /or that the corner points mentioned in lines 3, 4 and 5 above were in conformance with the rules of the Michigan Board of Land Surveyors or by a Decree of a Court of Law; established, re-established, monumented, recovered, found as expressed below:

NOTE: Not more than 2 corners, all in the same town and range, may be recorded on this certificate.


	A	B	C	D	E	F	G	H	I	J	K	L	M
1													
2	6		5		4		3		2		1		
3													
4	7		8		9		10		11		12		
5													
6	18		17		16		15		14		13		
7													
8	19		20		21		22		23		24		
9													
10	30		29		28		27		26		25		
11													
12	31		32		33		34		35		36		
13													

A. Description of original monument and accessories and/or subsequent restoration:

L5	G.L.O. Notes Set quarter Section Post Beech 30 S16W 10, Hemlock 6 N10W 11, and 14 Act 74 Form - None Act 132 Form - None Road Commission Record - None Drain Commission Record - None	K5	G.L.O. Notes Set Post Corner Sections 11, 12, 13, Hemlock 36 S85E 24, Hemlock 5 S56W 7 Act 74 Form - None Act 132 Form - None Road Commission Record - None Drain Commission Record - None
----	---	----	---

B. Description of corner evidence found and/or method applied in restoring or reestablishing corner:

L5	Found 3/4" Re-Rod in Monument Box	K5	Found 5/8" Re-Rod in Monument Box
----	-----------------------------------	----	-----------------------------------

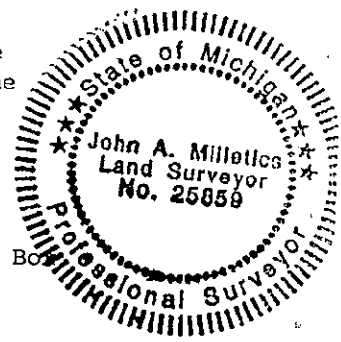

C. Description of monument for corner and accessories established to perpetuate locating the position of the corner:

L5	1/4 Corner Sections 12 and 13, T13N-R12E Found 3/4" Re-Rod in Monument Box WITNESSES: N45°E 29.85' to 1/2" Steel Stake S45°E 32.75' to 1/2" Steel Stake S45°W 25.10' to 1/2" Steel Stake N45°W 30.02' to 1/2" Steel Stake East 2705.20' to M5, T13N-R12E West 2703.95' to K5, T13N-R12E	K5	Corner Sections 11, 12, 13, and 14, T13N-R12E Found 5/8" Re-Rod in Monument Box WITNESSES: N45°E 52.0' to 1/2" Steel Stake S40°E 87.53' to Spike S.W. Side Corner Post S45°W 77.70' to Lag Bolt E. Side P.P. N45°W 69.55' to Spike S.W. Cor. 4"x4" Wood Post East 2703.95' to L5, T13N-R12E West 2630.83' to Apparent J5, T13N-R12E
----	---	----	---

Signed by John A. Millettics
Surveyor's Michigan License No. 25859

Date Nov 12, 1997

PEER GROUP APPROVED
AT MEETING HELD

NOV. 26 M, 1997