

RECEIVED FOR RECORD

98 DEC -1 AM 9:08

LIBER NO. 2 PAGE NO. 236

MICHELE VAN NORMAN  
REGISTER OF DEEDS  
SANILAC CO., MICHIGAN

REMONUMENTATION

LAND CORNER RECORDATION CERTIFICATE  
Filing Requirement of Act 74, Mich. P.A. 1970

For corners in

Sanilac (County)	Located In:	Corner Code #
1. Public Land Survey	T13N R13E	A-3
	T R	
	T R	
	T R	
2. Property Controlling in Section	S T R	
	S T R	
3. Miscellaneous Property in Sec.	S T R	
	S T R	

Register of Deeds Stamp & File Number

4. Lot No. \_\_\_\_\_, Recorded Plat \_\_\_\_\_  
5. Private Claims \_\_\_\_\_

I, John A. Milletics, in a field survey on Oct 5, 1998 do hereby state that under requirements of P.A. 74, Michigan P.A. of 1970, the corner points mentioned in lines 1 and 2 above were in conformance with regulations and rules therefore as required in the current manual of survey instructions of the United States Department of the Interior, Bureau of Land Management or by a decree of a Court of Law and/or that the corner points mentioned in lines 3, 4 and 5 above were in conformance with the rules of the Michigan Board of Land Surveyors or by a Decree of a Court of Law, established, re-established, monumented, recovered, found as expressed below:

NOTE: Not more than 2 corners, all in the same town and range, may be recorded on this certificate.

	A	B	C	D	E	F	G	H	I	J	K	L	M
1													
2	6		5		4		3		2		1		
3													
4	7		8		9		10		11		12		
5													
6	18		17		16		15		14		13		
7													
8	19		20		21		22		23		24		
9													
10	30		29		28		27		26		25		
11													
12	31		32		33		34		35		36		
13													


A. Description of original monument and accessories and/or subsequent restoration:

- 3 GLO Notes - B. Ash 10 S65W 21; B. Ash 6 N27 1/2W 10  
Old Survey Liber-Survey by Thomas Nicol 1911  
Road Comm - None  
Act 132 Liber 3 Page 704  
L.C.R.C. - None

SURVEY &  
REMONUMENTATION

JAN 15 1999

SECTION

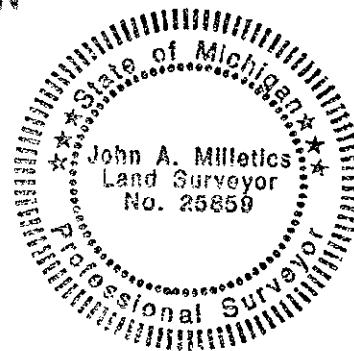

B. Description of corner evidence found and/or method applied in restoring or reestablishing corner:

- A - 3  
Found 1" Iron Pipe in Gravel Road Bed  
Accepted as best evidence  
  
North 2652.51' to the W 1/4 Corner Section 6  
  
South 2654.38' to the W 1/4 Corner Section 7

APPROVED PEER BOARD MEETING  
NOV 30, 1998

C. Description of monument for corner and accessories established to perpetuate locating the position of the corner:

- A-3  
  
1" Pipe  
N25°E, 39.80' Nail in 10" Cherry North 2652.51' to the W1/4 Corner Section 6  
S45°E, 63.65' Nail in Power Pole South 2654.38' to the W1/4 Corner Section 7  
N70°E, 50.80' Nail in 12" Poplar  
N25°W, 30.68' To Stop Sign  
S25°E, 35.70' To Stop Sign

Signed by John A. Milletics  
Surveyor's Michigan License No. 25859

Date Nov 18, 1998