

REMONUMENTATION

LAND CORNER RECORDATION CERTIFICATE
Filing Requirement of Act 74, Mich. P.A. 1970

98 DEC -1 AM 9:08

LIBER NO. 2 PAGE NO. 237

MICHELE VAN NORMAN
REGISTER OF DEEDS
SANILAC CO., MICHIGAN

For corners in

Sanilac (County)	Located In:	Corner Code #
1. Public Land Survey	T13N R13E	A-4
	T___ R___	_____
	T___ R___	_____
	T___ R___	_____
2. Property Controlling in Section	S___ T___ R___	_____
	S___ T___ R___	_____
3. Miscellaneous Property in Sec.	S___ T___ R___	_____
	S___ T___ R___	_____

Register of Deeds Stamp & File Number

4. Lot No. _____, Recorded Plat _____
5. Private Claims _____

I, John A. Milletics, in a field survey on Oct 5, 1998 do hereby state that under requirements of P.A. 74, Michigan P.A. of 1970, the corner points mentioned in lines 1 and 2 above were in conformance with regulations and rules therefore as required in the current manual of survey instructions of the United States Department of the Interior, Bureau of Land Management or by a decree of a Court of Law and /or that the corner points mentioned in lines 3, 4 and 5 above were in conformance with the rules of the Michigan Board of Land Surveyors or by a Decree of a Court of Law; established, re-established, monumented, recovered, found as expressed below:

NOTE: Not more than 2 corners, all in the same town and range, may be recorded on this certificate.

	A	B	C	D	E	F	G	H	I	J	K	L	M
1													
2	6		5		4		3		2		1		
3													
4	7		8		9		10		11		12		
5													
6	18		17		16		15		14		13		
7													
8	19		20		21		22		23		24		
9													
10	30		29		28		27		26		25		
11													
12	31		32		33		34		35		36		
13													


A. Description of original monument and accessories and/or subsequent restoration:

A-4 GLO Notes-- B. Ash 10 S43W 39; Birch: 9 N26W 4
Old Survey Liber--Survey by Thomas Nicol 1911
Road Comm - None
Act 132 - None
L.C.R.C. - None

SURVEY &
REMONUMENTATION

JAN 15 1999

SECTION

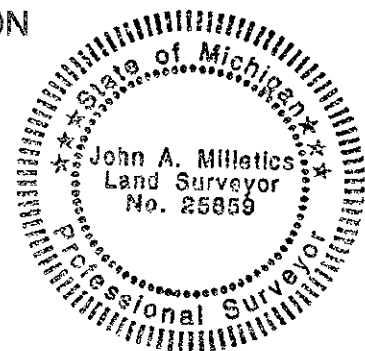

B. Description of corner evidence found and/or method applied in restoring or reestablishing corner:

A-4
W 1/4 Corner Section 7 T13N-R13E
Found 1/2" Iron bar in gravel road bed with cap
Accepted as best evidence

North 2654.38' to NW Corner Section 7

South 2654.38' to SW Corner Section 7

APPROVED PEER BOARD MEETING
NOV 30, 1998

C. Description of monument for corner and accessories established to perpetuate locating the position of the corner:

A-4

1/2" Iron Bar
N30°E, 38.14' Nail in 20" Ash North 2654.38' to NW Corner Section 7
East, 25.25' Nail in Fence Post South 2654.38' to SW Corner Section 7
N50°E, 27.50' Nail in Fence Post
S45°E, 27.57' Nail in 10" Apple

Signed by John A. Milletics
Surveyor's Michigan License No. 25859

Date Nov 18, 1998