

SURVEY & REMONUMENTATION

APR 14 1998

LIBER 2 PAGE 155

RECEIVED FOR RECORD

97 DEC -2 AM 9:09

LIBER NO. 2 PAGE NO. 155
ESTHER LEE
REGISTER OF DEEDS
SANILAC CO., MICHIGAN

SECTION

1997 REMONUMENTATION
LAND CORNER RECORDATION CERTIFICATE
Filing Requirement of Act 74, Mich. P.A. 1970

For corners in ARGYLE TOWNSHIP

SANILAC (County)	Located In:	Corner Code #
1. Public Land Survey	T13N R 13E	A5
	T R	
	T R	
	T R	
	T R	
2. Property Controlling in Section	S T R	
	S T R	
3. Miscellaneous Property in Sec.	S T R	
	S T R	

SURVEY & REMONUMENTATION

JAN 08 1998

Register of Deeds Stamp & File Number

4. Lot No. _____, Recorded Plat _____
5. Private Claims _____

I, John A. Milletics, in a field survey on Oct. 26, 19 97 do hereby state that under requirements of P.A. 74, Michigan P.A. of 1970, the corner points mentioned in lines 1 and 2 above were in conformance with regulations and rules therefore as required in the current manual of survey instructions of the United States Department of the Interior, Bureau of Land Management or by a decree of a Court of Law and /or that the corner points mentioned in lines 3, 4 and 5 above were in conformance with the rules of the Michigan Board of Land Surveyors or by a Decree of a Court of Law; established, re-established, monumented, recovered, found as expressed below:

	A	B	C	D	E	F	G	H	I	J	K	L	M
1													
2	6		5		4		3		2		1		
3													
4	7		8		9		10		11		12		
5													
6	10		17		16		15		14		13		
7													
8	19		20		21		22		23		24		
9													
10	30		29		28		27		26		25		
11													
12	31		32		33		34		35		36		
13													


NOTE: Not more than 2 corners, all in the same town and range, may be recorded on this certificate.

A. Description of original monument and accessories and/or subsequent restoration:

A5
G.L.O. Notes Set Post Corner Sections 12 and 13, T13N-R12E
Beech 14 S38W 40, Beech 11 N66W 13 1/2
Act 74 Form - None
Act 132 Form - L-2, Page 266
Road Commission Record - None
Drain Commission Record - None

B. Description of corner evidence found and/or method applied in restoring or reestablishing corner:

A5
Found 3/4" Re-Rod in Monument Box

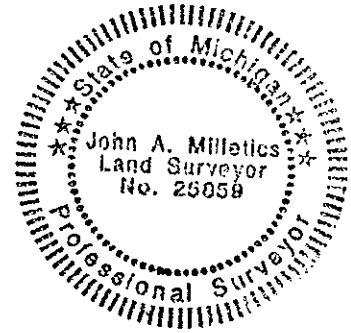

C. Description of monument for corner and accessories established to perpetuate locating the position of the corner:

A5 Corner Sections 7 and 18, T13N-R13E, and Corner Sections 12 and 13, T13N-R12E
Found 3/4" Re-Rod in Monument Box
WITNESSES:
N40°E 53.52' to 1/2" Steel Stake
S45°W 37.78' to 1/2" Steel Stake
S50°E 94.38' to P.K. Nail in S.W. Side P.P.
N40°W 45.90' to Notch in W. End 12" CMP
East 2616.57' to B5, T13N-R13E
West 2705.20' to L5, T13N-R12E

Signed by [Signature]
Surveyor's Michigan License No. 25859

Date Nov 12, 1997

PEER GROUP APPROVED
AT MEETING HELD

NOV. 26 1997