

98 DEC -1 AM 9:08

LIBER NO. 2 PAGE NO. 240

REMONUMENTATION

LAND CORNER RECORDATION CERTIFICATE
Filing Requirement of Act 74, Mich. P.A. 1970

MICHELE VAN NORMAN
REGISTER OF DEEDS
SANILAC CO., MICHIGAN

For corners in

Sanilac (County)	Located in:	Corner Code #
1. Public Land Survey	T13N R13E	A-8
	T R	
	T R	
	T R	
2. Property Controlling in Section	S T R	
	S T R	
3. Miscellaneous Property in Sec.	S T R	
	S T R	

Register of Deeds Stamp & File Number

- 4. Lot No. _____, Recorded Plat _____
- 5. Private Claims _____

I, John A. Milletics, in a field survey on Oct 5, 1998 do hereby state that under requirements of P.A. 74, Michigan P.A. of 1970, the corner points mentioned in lines 1 and 2 above were in conformance with regulations and rules therefore as required in the current manual of survey instructions of the United States Department of the Interior, Bureau of Land Management or by a decree of a Court of Law and /or that the corner points mentioned in lines 3, 4 and 5 above were in conformance with the rules of the Michigan Board of Land Surveyors or by a Decree of a Court of Law; established, re-established, monumented, recovered, found as expressed below:

NOTE: Not more than 2 corners, all in the same town and range, may be recorded on this certificate.


	A	B	C	D	E	F	G	H	I	J	K	L	M
1													
2	6		5		4		3		2		1		
3													
4	7		8		9		10		11		12		
5													
6	18		17		16		15		14		13		
7													
8	19		20		21		22		23		24		
9													
10	30		29		28		27		26		25		
11													
12	31		32		33		34		35		36		
13													

- A. Description of original monument and accessories and/or subsequent restoration:
A-8 Hemlock 10 S33 1/2W 31; Sugar 20 N64W 17
Old Survey Liber-Survey by Thomas Nicol 1906
Unrecorded survey dated 10-14-86
Act 132 - None
L.C.R.C. - None

SURVEY & REMONUMENTATION

JAN 15 1999

SECTION

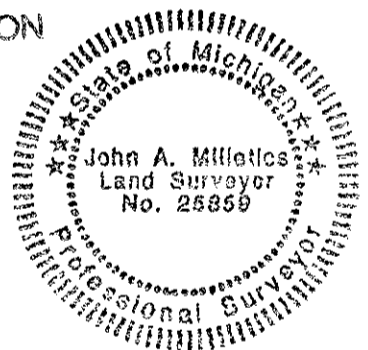

- B. Description of corner evidence found and/or method applied in restoring or reestablishing corner:

A-8
W 1/4 Corner Section 19 T13N-R13E
Found 1/2 Iron Bar
Accepted as best evidence
North 2647.20 feet to the NW Corner Section 19
South 2667.32 feet to the SW Corner Section 19

APPROVED PEER BOARD MEETING
NOV 30, 1998

- C. Description of monument for corner and accessories established to perpetuate locating the position of the corner:

A-8

1/2" Iron with cap
S80°E, 22.40' Nail in 18" Ash
N40°W, 46.20' Nail in Fence Post
S40°W, 47.95' Nail in 8" Ash
N50°W, 26.60' Nail in 10" Apple

North 2647.20 feet to the NW Corner Section 19
South 2667.32 feet to the SW Corner Section 19

Signed by John A. Milletics
Surveyor's Michigan License No. 25859

Date Nov 18, 1998