

RECEIVED FOR RECORD

REMONUMENTATION

LAND CORNER RECORDATION CERTIFICATE  
Filing Requirement of Act 74, Mich. P.A. 1970

98 DEC -1 AM 9:08

LIBER NO. 2 PAGE NO. 242

For corners in

Sanilac (County)	Located In:	Corner Code #
1. Public Land Survey	T13N R13E	A-10
	T R	
	T R	
	T R	
2. Property Controlling in Section	S T R	
	S T R	
3. Miscellaneous Property in Sec.	S T R	
	S T R	

MICHELE VANNORMAN  
REGISTER OF DEEDS  
SANILAC CO., MICHIGAN

Register of Deeds Stamp & File Number

4. Lot No. \_\_\_\_\_, Recorded Plat \_\_\_\_\_  
5. Private Claims \_\_\_\_\_

I, John A. Millettics, in a field survey on Oct 5, 1998 do hereby state that under requirements of P.A. 74, Michigan P.A. of 1970, the corner points mentioned in lines 1 and 2 above were in conformance with regulations and rules therefore as required in the current manual of survey instructions of the United States Department of the Interior, Bureau of Land Management or by a decree of a Court of Law and /or that the corner points mentioned in lines 3, 4 and 5 above were in conformance with the rules of the Michigan Board of Land Surveyors or by a Decree of a Court of Law; established, re-established, monumented, recovered, found as expressed below:

NOTE: Not more than 2 corners, all in the same town and range, may be recorded on this certificate.

	A	B	C	D	E	F	G	H	I	J	K	L	M
1													
2	6		5		4		3		2		1		
3													
4	7		8		9		10		11		12		
5													
6	18		17		16		15		14		13		
7													
8	19		20		21		22		23		24		
9													
10	30		29		28		27		26		25		
11													
12	31		32		33		34		35		36		
13													

A. Description of original monument and accessories and/or subsequent restoration:

A-10 GLO Notes - Hemlock 12 N49W 31; Hemlock 10 S14W 20

Old Survey Liber-Survey by Thomas Nicol 1905  
Act 132 - Liber 4 Page 126  
L.C.R.C. - None


North 2664.90 feet to the NW Corner Section 30

South 2655.82 feet to the SW Corner Section 30

SURVEY & REMONUMENTATION

JAN 15 1999

SECTION

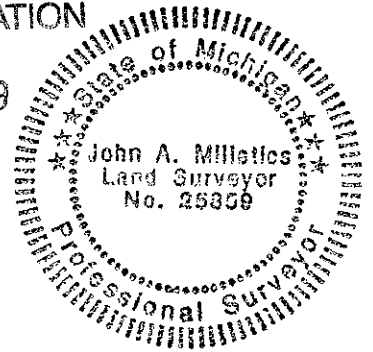

B. Description of corner evidence found and/or method applied in restoring or reestablishing corner:

A-10 W 1/4 Corner Section 30 T13N-R13E  
Found 1" Iron Bar in gravel road bed  
Accepted as best evidence

North 2664.90 feet to the NW Corner Section 30

South 2655.82 feet to the SW Corner Section 30

APPROVED PEER BOARD MEETING  
NOV 30, 1998

C. Description of monument for corner and accessories established to perpetuate locating the position of the corner:

A-10

1" Iron Bar  
S80°E, 25.50' East End of 18" CMP  
S80°W, 22.10' West End of 18" CMP  
West, 44.60' Nail in Fence Post  
N80°W, 44.60' Nail in Fence Post

North 2664.90 feet to the NW Corner Section 30  
South 2655.82 feet to the SW Corner Section 30

Signed by John A. Millettics  
Surveyor's Michigan License No. 25859

Date Nov 18, 1998