

SURVEY & REMONUMENTATION

APR 14 1998

LIBER 2 PAGE 152

RECEIVED FOR RECORD

SECTION

1997 REMONUMENTATION
LAND CORNER RECORDATION CERTIFICATE
Filing Requirement of Act 74, Mich. P.A. 1970

97 DEC -2 AM 9:08

For corners in ARGYLE TOWNSHIP

LIBER NO. 2 PAGE NO. 152
ESTHER LEE
REGISTER OF DEEDS
SANILAC CO. MICHIGAN

SANILAC (County)	Located In:	Corner Code #
1. Public Land Survey	T 13N R 13E T 13N R 13E T R T R	C5 B5
2. Property Controlling in Section	S T R S T R	
3. Miscellaneous Property in Sec.	S T R S T R	

SURVEY & REMONUMENTATION

JAN 08 1998

Register of Deeds Stamp & File Number

4. Lot No. _____, Recorded Plat _____
5. Private Claims _____

I, John A. Milletics, in a field survey on Oct. 25 19 97 do hereby state that under requirements of P.A. 74, Michigan P.A. of 1970, the corner points mentioned in lines 1 and 2 above were in conformance with regulations and rules therefore as required in the current manual of survey instructions of the United States Department of the Interior, Bureau of Land Management or by a decree of a Court of Law and/or that the corner points mentioned in lines 3, 4 and 5 above were in conformance with the rules of the Michigan Board of Land Surveyors or by a Decree of a Court of Law, established, re-established, monumented, recovered, found as expressed below:

	A	B	C	D	E	F	G	H	I	J	K	L	M
1													
2	6	5	4	3	2	1							
3													
4	7	8	9	10	11	12							
5	•	•											
6	18	17	16	15	14	13							
7													
8	19	20	21	22	23	24							
9													
10	30	29	28	27	26	25							
11													
12	31	32	33	34	35	36							
13													

NOTE: Not more than 2 corners, all in the same town and range, may be recorded on this certificate.

A. Description of original monument and accessories and/or subsequent restoration:


C5
G.L.O. Notes Set Post Corner Sec's. 7, 8, 17 & 18
Elm 12 S37E 19, Hemlock 14 N37W 24
Act 74 Form - None
Act 132 Form - L 3, Page 442
Road Commission Record - None
Drain Commission Record - None
Unrecorded Survey - Huron Surveying
August 7, 1997

B5
G.L.O. Notes Set quarter Section Post
Hemlock 9 N151/2W 10, Hemlock 14 S32E 17
Act 74 Form - None
Act 132 Form - L 3, Page 442 and
L2, Page 266
Road Commission Record - None
Drain Commission Record - None

B. Description of corner evidence found and/or method applied in restoring or reestablishing corner:

C5
Found 5/8" Re-Rod in Monument Box

B5
Found 3/4" Re-Rod in Monument Box

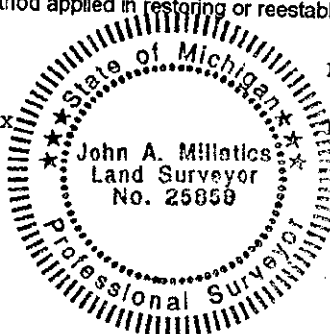

C. Description of monument for corner and accessories established to perpetuate locating the position of the corner:

C5
Corner Sections 7, 8, 17, & 18, T13N-R13E
Found 5/8" Re-Rod in Monument Box
WITNESSES:
N40°E 57.25' to 1/2" Steel Stake
N45°W 56.55' to 1/2" Steel Stake
S25°W 92.0' to Spike S.W. Side 12" Oak
S50°E 70.95' to P.K. Nail in S.W. Side P.P.
East 2635.15' to D5, T13N-R13E
West 2613.95' to B5, T13N-R13E

B5
1/4 Corner Sections 7 & 18, T13N-R13E
Found 3/4" Re-Rod in Monument Box
WITNESSES:
N45°E 31.41' to 1/2" Steel Stake
S45°E 32.10' to 1/2" Steel Stake
S45°W 31.16' to 1/2" Steel Stake
N45°W 31.71' to 1/2" Steel Stake
East 2613.95' to C5, T13N-R13E
West 2616.57' to A5, T13N-R13E

Signed by John A. Milletics
Surveyor's Michigan License No. 25859

Date Nov 12, 1997

PEER GROUP APPROVED
AT MEETING HELD
NOV. 26 1997