

SURVEY & REMONUMENTATION

APR 14 1998

LIBER

2 PAGE 153

RECEIVED FOR RECORD

1997 REMONUMENTATION

97 DEC -2 AM 9:08

LAND CORNER RECORDATION CERTIFICATE

Filing Requirement of Act 74, Mich. P.A. 1976

LIBER NO. 2 PAGE NO. 153

ESTHER LEE REGISTER OF DEEDS SANILAC CO. MICHIGAN

SECTION

For corners in ARGYLE

SANILAC

(County)

Located In:

Corner Code #

1. Public Land Survey

T 13N R 13E	E5
T 13N R 13E	D5
T R	
T R	
S T R	
S T R	
S T R	
S T R	

2. Property Controlling in Section

3. Miscellaneous Property in Sec.

4. Lot No. , Recorded Plat
5. Private Claims

SURVEY & REMONUMENTATION

JAN 08 1998

Register of Deeds Section & File Number

I, John A. Millettica, in a field survey on Oct. 25 19 97 do hereby state that under requirements of P.A. 74, Michigan P.A. of 1970, the corner points mentioned in lines 1 and 2 above were in conformance with regulations and rules therefore as required in the current manual of survey instructions of the United States Department of the Interior, Bureau of Land Management or by a decree of a Court of Law and for that the corner points mentioned in lines 3, 4 and 5 above were in conformance with the rules of the Michigan Board of Land Surveyors or by a Decree of a Court of Law; established, re-established, monumented, recovered, found as expressed below:

NOTE: Not more than 2 corners, all in the same town and range, may be recorded on this certificate.

A	B	C	D	E	F	G	H	I	J	K	L	M
1												
2	6	5	4	3	2	1						
3												
4	7	8	9	10	11	12						
5												
6	18	17	16	15	14	13						
7												
8	19	20	21	22	23	24						
9												
10	30	29	28	27	26	25						
11												
12	31	32	33	34	35	36						
13												


A. Description of original monument and accessories and/or subsequent restoration:

E5
G.L.O. Notes Set Post Cor. Sec's. 8, 9, 16, and 17
Maple 12 S54E 20, Maple 10 N27E 26
Act 74 Form - None
Act 132 Form - L 3, Page 198, & L 3, Page 99
Road Commission Record - None
Drain Commission Record - None

D5
G.L.O. Notes Set quarter Section Post Elm 9 N5W 10, Elm 7 S19E 11
Act 74 Form - None
Act 132 Form - L 3, Page 99
Road Commission Record - None
Drain Commission Record - None

B. Description of corner evidence found and/or method applied in restoring or reestablishing corner:

E5 Found 5/8" Re-Rod in Monument Box
D5 Found 1/2" Re-Rod in Monument Box

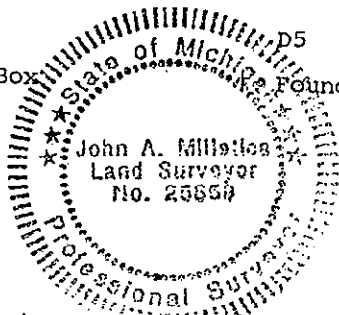

C. Description of monument for corner and accessories established to perpetuate locating the position of the corner:

E5
Cor. Sec's. 8, 9, 16 & 17, T13N-R13E
WITNESSES:
N45°E 44.22' to 1/2" Steel Stake
S50°E 83.98' to Spike S.W. Side 28" Ash
S45°W 100.68' to Spike N.W. Side 18" Ash
N45°W 44.98' to Notch W. End 72" CMP
East 2655.47' Apparent F5, T13N-R13E
West 2634.36' to D5, T13N-R13E
Found 5/8" Re-Rod in Monument Box

D5
1/4 Cor. Sec's. 8 and 17, T13N-R13E
Found 1/2" Re-Rod in Monument Box
WITNESSES:
N40°W 73.90' to Nail in 18" Maple
N15°W 49.75' to Nail in 12" Poplar
N30°E 65.14' to Nail in 15" Poplar
S30°W 50.50' to Nail in 8" Poplar
South 62.25' to Nail in 8" Ash
East 2634.36' to E5, T13N-R13E
West 2635.15' to C5, T13N-R13E
Date Nov 12, 1997

Signed by John A. Millettica
Surveyor's Michigan License No. 25859

PEER GROUP APPROVED
AT MEETING HELD
NOV. 26 1997