

MAY 07 1997

REMONUMENTATION LAND CORNER RECORDATION CERTIFICATE Filing Requirement of Act 74, Mich. P.A. 1970

RECEIVED FOR RECORD

96 DEC 10 AM 11:57

LIBER NO. 2 PAGE NO. 111 ESTHER LEE REGISTER OF DEEDS SANILAC CO., MICHIGAN

For corners in COMMISSION

Table with columns: Sanilac (County), Located In, Corner Code #. Rows include Public Land Survey, Property Controlling in Section, Miscellaneous Property in Sec., Lot No., and Private Claims.

Register of Deeds Stamp & File Number

I, John A. Milletics, in a field survey on May 25, 1996, do hereby certify that under requirements of P.A. 74, Michigan P.A. of 1970, the corner points mentioned in lines 1 and 2 above were in conformance with regulations and rules therefore as required in the current manual of survey instructions of the United States Department of the Interior, Bureau of Land Management or by a decree of a Court of Law and/or that the corner points mentioned in lines 3, 4 and 5 above were in conformance with the rules of the Michigan Board of Land Surveyors or by a Decree of a Court of Law; established, re-established, monumented, re-monumented, recovered, found as expressed below:

Grid table with columns A-M and rows 2-13. Contains numbers 1-36 in a grid pattern.

NOTE: Not more than 4 corners, all in the same town and range, may be recorded on this certificate.

- A. Description of original monument and accessories and/or subsequent restoration: D - 13 GLO Notes, E - 13 GLO Notes.

B. Description of corner evidence found and/or method applied in restoring or reestablishing corner:

- D - 13 S 1/4 Corner Section 32 T13N-R14E Found 1/2" Pipe In Gravel Road Bed half way between the SE and SW Corners. E - 13 SE Corner Section 32 T13N-R14E Found Monu Box.


APPROVED PEER BOARD MEETING 12-02-96 JM

C. Description of monument for corner and accessories established to perpetuate locating the position of the corner:

- D - 13 S 1/4 Cor Section 32 T13N-R14E 1/2" Pipe in gravel Road Bed North 50.40 to a nail in a Power Pole S05°W 20.10 to the east end of a 12" CMP S45°W 42.10 to the west end of a 12" CMP West 15.18 to a 1/2" Hex Bar in Gravel Road Bed N 1/4 Corner Section 5 West 2654.22 to the SW of Section 32. E - 13 SE Corner Section 32 T13N-R14E Monu Box S45°E 50.50 to a nail in a Power Pole N50°E 59.80 to a nail in a 24" Pine N70°E 77.15 to a nail in a 24" Pine West 10.56 feet to a Monu Box on the Centerline of Pavement be the NE of Section 5 West 2654.22 to the S 1/4 Cor Section 32

Signed by [Signature] Surveyor's Michigan License No. 25859

Date Aug 3, 1996

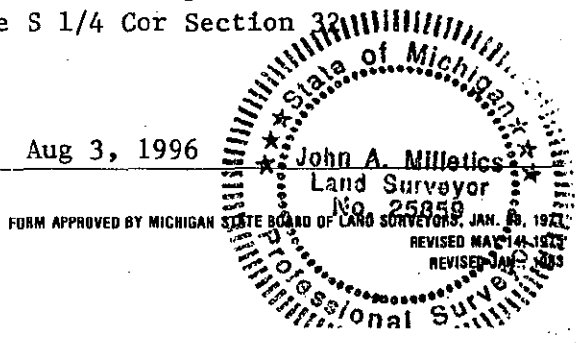

FORM APPROVED BY MICHIGAN STATE BOARD OF LAND SURVEYORS, JAN. 28, 1973 REVISED JAN 1983