

RECORDED

MAY 6 1997

LIBER

2 PAGE 94

REMONUMENTION

RECEIVED FOR RECORD

COMMISSION

LAND CORNER RECORDATION CERTIFICATE

96 DEC 10 AM 11:55

Filing Requirement of Act 74, Mich. P.A. 1970

LIBER NO. 2 PAGE NO. 94  
ESTHER LEE  
REGISTER OF DEEDS  
SANILAC CO. MICHIGAN

For corners in

Sanilac (County)	Located In:	Corner Code #
1. Public Land Survey	T 13N R 14E	L-13 M-13
	T _____ R _____	_____
	T _____ R _____	_____
	T _____ R _____	_____
2. Property Controlling in Section	S _____ T _____ R _____	_____
	S _____ T _____ R _____	_____
3. Miscellaneous Property in Sec.	S _____ T _____ R _____	_____
	S _____ T _____ R _____	_____

Register of Deeds Stamp & File Number

4. Lot No. \_\_\_\_\_, Recorded Plat \_\_\_\_\_  
5. Private Claims \_\_\_\_\_

I, JOHN A MILLETICS, in a field survey on June 1, 19 96, do hereby certify that under requirements of P.A. 74, Michigan P.A. of 1970, the corner points mentioned in lines 1 and 2 above were in conformance with regulations and rules therefore as required in the current manual of survey instructions of the United States Department of the Interior, Bureau of Land Management or by a decree of a Court of Law and/or that the corner points mentioned in lines 3, 4 and 5 above were in conformance with the rules of the Michigan Board of Land Surveyors or by a Decree of a Court of Law; established, re-established, monumented, re-monumented, recovered, found as expressed below:

NOTE: Not more than 4 corners, all in the same town and range, may be recorded on this certificate.

A. Description of original monument and accessories and/or subsequent restoration:

L - 13 GLO NOTES No Survey in Old Liber  
40.00 Set 1/4 Section Post Act 74 None, Act 132 None  
Cedar 16 N50W 39 No Road or Drain Comm Records  
Cedar 8 N55E 36


M - 13 GLO NOTES No Survey in Old Liber  
Beech 13 N31W 27 Act 132 None, Act 74 None  
Pine 30 South 38 No Road or Drain Comm. Records  
Beech 13 N31W 27  
Beech 11 S52 1/2 E 40

B. Description of corner evidence found and/or method applied in restoring or reestablishing corner:

L - 13  
S 1/4 Corner Section 36 T13N-R14E  
Found 1/2" Iron Bar in Gravel Road Bed  
at half distance between SE and SW Cor

M - 13  
SE Corner Section 36 T13N-R14E  
Found 1/2" Iron Bar in gravel Road Bed

	A	B	C	D	E	F	G	H	I	J	K	L	I
2	6	5	4	3	2	1							
3													
4	7	8	9	10	11	12							
5													
6	18	17	16	15	14	13							
7													
8	19	20	21	22	23	24							
9													
10	30	29	28	27	26	25							
11													
12	31	32	33	34	35	36							
13													

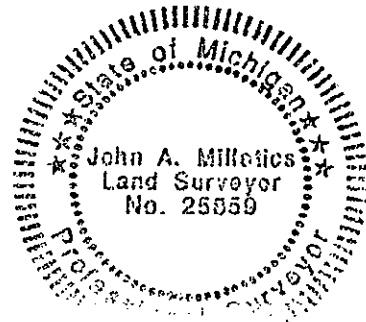

APPROVED PEER BOARD MEETING

12-02-96 JM

C. Description of monument for corner and accessories established to perpetuate locating the position of the corner:

L - 13 1/2" Iron Bar  
S 1/4 Corner Section 36 T13N-R14E  
S05°W 26.60 to a nail in a 6" Ash  
S15°W 32.10 to a metal fence post  
S70°W 54.70 to a nail in a 6" Ash  
West 2647.74 feet to the SW Cor Section 36  
East 19.80 to a 1/2" Iron Bar N 1/4 Corner  
Section 1

M - 13  
SE Corner Section 36 T13N-R14E  
1/2" Iron Bar in gravel Road Beds  
S40°W 65.20 to a nail in a Power Pole  
S50°E 62.60 to a nail in a Bell Post  
N45°E 48.25 to a Stop Sign  
S45°W 38.30 to a Stop Sign  
West 2647.74 feet to the S 1/4 Corner Section 36

Signed by

Date Aug 4, 1996

Surveyor's Michigan License No. 25859