

SURVEY & REMONUMENTATION

APR 14 1998

LIBER 2 PAGE 173

RECEIVED FOR RECORD

97 DEC -2 AM 9:10

REMONUMENTATION SECTION

LAND CORNER RECORDATION CERTIFICATE
Filing Requirement of Act 74, Mich. P.A. 1970

LIBER NO. 2 PAGE NO. 173
ESTHER LEE
REGISTER OF DEEDS
SANILAC CO. MICHIGAN

For corners in WHEATLAND TOWNSHIP

<u>Sanilac</u> (County)	Located In:	Corner Code #
1. Public Land Survey	T 13NR 14E	E - 13
	T R	
	T R	
	T R	
2. Property Controlling in Section	S T R	
	S T R	
3. Miscellaneous Property in Sec.	S T R	
	S T R	

SURVEY & REMONUMENTATION

JAN 08 1998

Register of Deeds Stamp & File Number

4. Lot No. _____, Recorded Plat _____
5. Private Claims _____

SECTION

1	A	B	C	D	E	F	G	H	I	J	K	L	M
2		6		5		4		3		2		1	
3													
4		7		8		9		10		11		12	
5													
6		18		17		16		15		14		13	
7													
8		19		20		21		22		23		24	
9													
10		30		29		28		27		26		25	
11													
12		31		32		33		34		35		36	
13													

I, John A Milletics, in a field survey on July 28, 19 97 do hereby state that under requirements of P.A. 74, Michigan P.A. of 1970, the corner points mentioned in lines 1 and 2 above were in conformance with regulations and rules therefore as required in the current manual of survey instructions of the United States Department of the Interior, Bureau of Land Management or by a decree of a Court of Law and /or that the corner points mentioned in lines 3, 4 and 5 above were in conformance with the rules of the Michigan Board of Land Surveyors or by a Decree of a Court of Law; established, re-established, monumented, recovered, found as expressed below:

NOTE: Not more than 2 corners, all in the same town and range, may be recorded on this certificate.

A. Description of original monument and accessories and/or subsequent restoration:
E - 13

GLO NOTES

Set Post Corner	Old Survey Liber, Survey dated may 1896 by Ward
Beech 8 N50 1/2° E 31	survey dated Aug 1886 by Rogers
Beech 9 N60° W 54	Act 74 Liber 1, Page 111
	Act 132 None, unrecorded survey dated 4-92

B. Description of corner evidence found and/or method applied in restoring or reestablishing corner:

E - 13


Found Monu Box - removed by Sanilac County Road Comm during reconstruction of road (Aug) REPLACED using Act 74 as recorded Liber1, Page 111

APPROVED PEER BOARD MEETING
NOV. 26, 1997 *JM*

C. Description of monument for corner and accessories established to perpetuate locating the position of the corner:

E - 13

SE Corner Section 32 T13N-R14E
Monu Box in Place with 5/8" iron bar
West 10.56 to a Moun Box
S45°E 50.50 feet to a nail in a Power Pole
N50°E 59.80 feet to a nail in a 24" Pine
N70°E 77.15 feet to a nail in a 24" Pine
West 2654.22 feet to the S 1/4 Corner Section 32

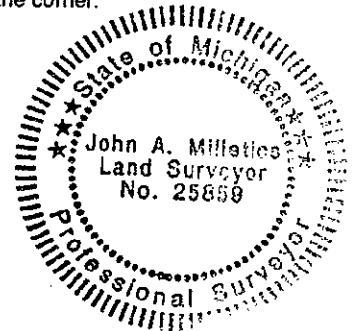

Signed by John A Milletics
Surveyor's Michigan License No. 25859

Date Nov 12, 1997