

RECEIVED FOR RECORD

98 DEC -1 AM 9:09

LIBER NO. 2 PAGE NO. 264

REMONUMENTATION

LAND CORNER RECORDATION CERTIFICATE  
Filing Requirement of Act 74, Mich. P.A. 1970

For corners in

Sanilac (County)	Located In:	Corner Code #
1. Public Land Survey	T13N R15E	A-5
	T R	
	T R	
	T R	
2. Property Controlling in Section	S T R	
	S T R	
3. Miscellaneous Property in Sec.	S T R	
	S T R	

MICHELE VANNORMAN  
REGISTER OF DEEDS  
SANILAC CO., MICHIGAN

Register of Deeds Stamp & File Number

4. Lot No. \_\_\_\_\_, Recorded Plat \_\_\_\_\_  
5. Private Claims \_\_\_\_\_

I, John A. Milletics, in a field survey on Oct 12, 19 98 do hereby state that under requirements of P.A. 74, Michigan P.A. of 1970, the corner points mentioned in lines 1 and 2 above were in conformance with regulations and rules therefore as required in the current manual of survey instructions of the United States Department of the Interior, Bureau of Land Management or by a decree of a Court of Law and /or that the corner points mentioned in lines 3, 4 and 5 above were in conformance with the rules of the Michigan Board of Land Surveyors or by a Decree of a Court of Law; established, re-established, monumented, recovered, found as expressed below:

NOTE: Not more than 2 corners, all in the same town and range, may be recorded on this certificate.

	A	B	C	D	E	F	G	H	I	J	K	L	M
1													
2	6		5		4		3		2		1		
3													
4	7		8		9		10		11		12		
5													
6	18		17		16		15		14		13		
7													
8	19		20		21		22		23		24		
9													
10	30		29		28		27		26		25		
11													
12	31		32		33		34		35		36		
13													


A. Description of original monument and accessories and/or subsequent restoration:

A-5 GLO Notes - Cedar 10 S69W 7; Cedar 11 N21W 36  
Old Survey Liber - None  
L.C.R.C. - None  
Act 132 - None  
Unrecorded survey dated 8-19-80  
Road Comm - None

B. Description of corner evidence found and/or method applied in restoring or reestablishing corner:

A-5  
SW Corner Section 7 T13N-R15E  
Found 5/8" Iron bar in gravel road bed  
Accepted as best evidence  
South 2639.81 feet to the W 1/4 Corner Section 18  
North 2686.68 feet to the W 1/4 Corner Section 7

APPROVED PEER BOARD MEETING  
NOV 30, 1998

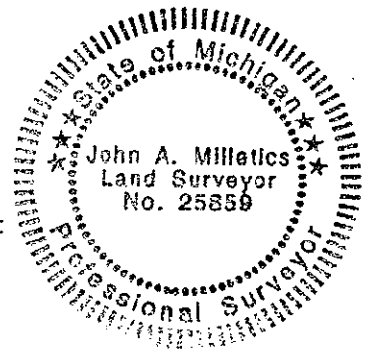

C. Description of monument for corner and accessories established to perpetuate locating the position of the corner:

A-5  
SW Corner Section 7 T13N-R15E  
5/8" Iron Bar  
N70°E 70.30 to a nail in a Telephone Pole  
S45°W 50.55 to a nail in a Power Pole  
West 17.00 to the East Rail of the Railroad Tracks  
N20°W 37.50 to a Stop Sign  
North 2686.68 feet to the W 1/4 Corner Section 7  
South 2639.81 feet to the W 1/4 Corner Section 18

SURVEY &  
REMONUMENTATION

JAN 15 1999

SECTION

Signed by John A. Milletics  
Surveyor's Michigan License No. 25859

Date Nov 19, 98