

REMONUMENTATION

LAND CORNER RECORDATION CERTIFICATE  
Filing Requirement of Act 74, Mich. P.A. 1970

RECEIVED FOR RECORD

98 DEC -1 AM 9:10

LIBER NO. 2 PAGE NO. 267

MICHELE VAN NORMAN  
REGISTER OF DEEDS  
SANILAC CO., MICHIGAN

Register of Deeds Stamp & File Number

For corners in

Sanilac (County)	Located In:	Corner Code #
1. Public Land Survey	T13N R15E	A-8
	T R	
	T R	
	T R	
2. Property Controlling in Section	S T R	
	S T R	
3. Miscellaneous Property in Sec.	S T R	
	S T R	

4. Lot No. \_\_\_\_\_, Recorded Plat \_\_\_\_\_  
5. Private Claims \_\_\_\_\_

I, John A. Milletics, in a field survey on Oct 12, 19 98 do hereby state that under requirements of P.A. 74, Michigan P.A. of 1970, the corner points mentioned in lines 1 and 2 above were in conformance with regulations and rules therefore as required in the current manual of survey instructions of the United States Department of the Interior, Bureau of Land Management or by a decree of a Court of Law and/or that the corner points mentioned in lines 3, 4 and 5 above were in conformance with the rules of the Michigan Board of Land Surveyors or by a Decree of a Court of Law; established, re-established, monumented, recovered, found as expressed below:

NOTE: Not more than 2 corners, all in the same town and range, may be recorded on this certificate.


	A	B	C	D	E	F	G	H	I	J	K	L	M
1													
2	6		5		4		3		2		1		
3													
4	7		8		9		10		11		12		
5													
6	18		17		16		15		14		13		
7													
8	19		20		21		22		23		24		
9													
10	30		29		28		27		26		25		
11													
12	31		32		33		34		35		36		
13													

A. Description of original monument and accessories and/or subsequent restoration:

A-8 GLO Notes - Cedar 18 S7W 12; Cedar 15 N52W 38  
Old Survey Liber - None  
L.C.R.C. - None  
Act 132 - None  
Unrecorded Survey - dated 8-22-85

B. Description of corner evidence found and/or method applied in restoring or reestablishing corner:

A-8  
W 1/4 Corner Section 19 T13N-R15E  
Found 5/8" Iron Bar in gravel Road Bed  
Accepted as best evidence  
North 2654.36 feet to the NW Corner Section 19  
South 2659.96 feet to the SW Corner Section 19

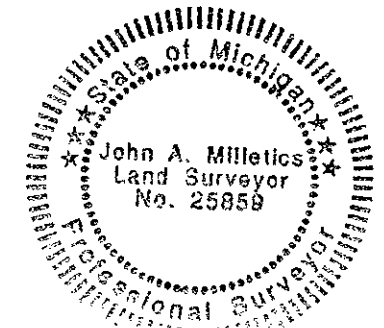

APPROVED PEER BOARD MEETING  
NOV 30, 1998

*JM*

C. Description of monument for corner and accessories established to perpetuate locating the position of the corner:

A-8  
W 1/4 Corner Section 19 T13N-R15E  
5/8" Iron Bar  
S60°W 55.70 feet to a nail in a Power Pole  
S25°E 106.75 feet to a nail in a 18" Maple  
West 33.00 feet to a 1/2" iron bar  
North 2654.36 feet to the NW Corner Section 19  
South 2659.96 feet to the SW Corner Section 19

SURVEY &  
REMONUMENTATION

JAN 15 1999

SECTION

Signed by John A. Milletics  
Surveyor's Michigan License No. 25859

Date Nov 19, 98