

COMMISSION

REMONUMENTION LAND CORNER RECORDATION CERTIFICATE 96 DEC 10 AM 11:56

Filing Requirement of Act 74, Mich. P.A. 1970

LIBER NO. 2 PAGE NO. 95  
ESTHER LEE  
REGISTER OF DEEDS  
SANILAC CO., MICHIGAN

For corners in

Sanilac (County)	Located In:	Corner Code #
1. Public Land Survey	T 13N R 15E	B-13 - C-13
	T _____ R _____	_____
	T _____ R _____	_____
	T _____ R _____	_____
2. Property Controlling in Section	S _____ T _____ R _____	_____
	S _____ T _____ R _____	_____
3. Miscellaneous Property in Sec.	S _____ T _____ R _____	_____
	S _____ T _____ R _____	_____

Register of Deeds Stamp & File Number

- 4. Lot No. \_\_\_\_\_, Recorded Plat \_\_\_\_\_
- 5. Private Claims \_\_\_\_\_

	A	B	C	D	E	F	G	H	I	J	K	L	M
2	6	5	4	3	2	1							
3													
4	7	8	9	10	11	12							
5													
6	16	17	18	15	14	13							
7													
8	19	20	21	22	23	24							
9													
10	30	29	28	27	26	25							
11													
12	31	32	33	34	35	36							
13													

I, John A Milletics, in a field survey on June 8, 1996, do hereby certify that under requirements of P.A. 74, Michigan P.A. of 1970, the corner points mentioned in lines 1 and 2 above were in conformance with regulations and rules therefore as required in the current manual of survey instructions of the United States Department of the Interior, Bureau of Land Management or by a decree of a Court of Law and/or that the corner points mentioned in lines 3, 4 and 5 above were in conformance with the rules of the Michigan Board of Land Surveyors or by a Decree of a Court of Law; established, re-established, monumented, re-monumented, recovered, found as expressed below:


**NOTE: Not more than 4 corners, all in the same town and range, may be recorded on this certificate.**

A. Description of original monument and accessories and/or subsequent restoration:  
 B - 13 GLO Notes No Survey in Old Liber  
 40.00 Set 1/4 Section Post Act 74 None  
 Hemlock 9 N72 1/2 E 10 Act 132 None  
 Lynn 9 N72 W 17 1/2 Unrecorded Survey dated 10-9-91  
 Notes from I.E.C. Survey dated 12-5-75

C - 13 GLO Notes No Survey in Old Liber  
 80.00 Set Post Corner Act 74 None  
 Sugar 30 N46 1/2 E 31 Act 132 Liber 3 Page 366  
 Hemock 30 N59W 31 No Road Comm or Drain Comm Notes

B. Description of corner evidence found and/or method applied in restoring or reestablishing corner:  
 B - 13  
 S 1/4 Cor. Section 31 T13N-R15E  
 Found 1/2" iron bar in gravel road bed  
 in line with 5/8" iron bar to east

C - 13  
 Found Monu Box 6.0 feet west of pavement centerline  
 as per State Highway Right of Way Book Page 83

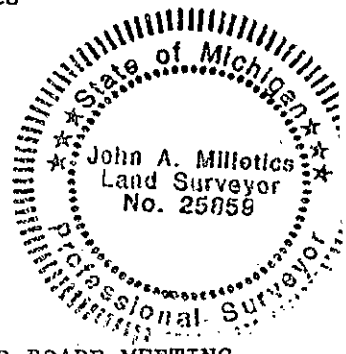

APPROVED PEER BOARD MEETING  
12-02-96 JM

C. Description of monument for corner and accessories established to perpetuate locating the position of the corner:  
 B - 13 C - 13  
 S 1/4 Corner Section 31 T13N-R15E SE Cor Section 31 T13N-R15E  
 1/2" iron bar in gravel Road Bed Monu Box  
 East 43.70 feet to a 5/8" iron Bar S45°E 81.60 feet to a Gas Post  
 S40°E 69.25 feet to a nail in a Power Pole East 6.00 feet to the Centerline of Pavement  
 S10°E 37.54 feet to a nail in a Fence Post N45°W 52.50 feet to a nail in a Tele Pole  
 S20°E 59.00 feet to a Metal Fence Post N50°E 105.60 feet to a nail in a Power Pole  
 West 2538.69 feet to the SW Cor of Section 31 West 2643.18 feet to the S 1/4 Cor Section 31

Signed by [Signature] Date Aug 24, 1996  
 Surveyor's Michigan License No. 25859