

REMONUMENTION  
LAND CORNER RECORDATION CERTIFICATE  
Filing Requirement of Act 74, Mich. P.A. 1970

RECEIVED FOR RECORD

96 DEC 10 AM 11:56

LIBER NO. 2 PAGE NO. 96  
ESTHER LEE  
REGISTER OF DEEDS  
SANILAC CO. MICHIGAN

For corners in

Sanilac  
(County)

Located in:

Corner Code #

- 1. Public Land Survey T13N R15E D-13 E-13  
T R  
T R  
T R
- 2. Property Controlling S T R  
In Section S T R
- 3. Miscellaneous S T R  
Property in Sec. S T R

Register of Deeds Stamp & File Number

4. Lot No. \_\_\_\_\_, Recorded Plat \_\_\_\_\_  
5. Private Claims \_\_\_\_\_

I, John A Milletics, in a field survey on June 8, 1996 do hereby state that under requirements of P.A. 74, Michigan P.A. of 1970, the corner points mentioned in lines 1 and 2 above were in conformance with regulations and rules therefore as required in the current manual of survey instructions of the United States Department of the Interior, Bureau of Land Management or by a decree of a Court of Law and /or that the corner points mentioned in lines 3, 4 and 5 above were in conformance with the rules of the Michigan Board of Land Surveyors or by a Decree of a Court of Law, established, re-established, monumented, recovered, found as expressed below:

NOTE: Not more than 2 corners, all in the same town and range, may be recorded on this certificate.


	A	B	C	D	E	F	G	H	I	J	K	L
1												
2	6		5		4		3		2		1	
3												
4	7		8		9		10		11		12	
5												
6	10		17		16		15		14		13	
7												
8	19		20		21		22		23		24	
9												
10	30		29		28		27		26		25	
11												
12	31		32		33		34		35		36	
13												

A. Description of original monument and accessories and/or subsequent restoration:

- D - 13 GLO Notes No Survey in Old Liber  
40.00 Set 1/4 Section Post No Act 74, No act 132  
Hemlock 18 N73 1/2 E 19 No Road Comm or Drain Co. Notes  
Hemlock 9 N71 W 41 Old Plat recorded Liber 1 Page 27 1884
- E -13 GLO Notes No Survey in Old Liber  
80.00 Set Post Corner NO Act 132, No act 74  
Hemlock 14 N74E 8 Road Comm shows found iron bar  
Hemlock 20 N68W 60

B. Description of corner evidence found and/or method applied in restoring or reestablishing corner:

- D - 13 S 1/4 Cor Section 32 T13N-R15E  
Set 1/2 Iron Bar at half distance  
checks with plat as recorded Liber 1 Page 27
- E - 13 SE Cor Section 32 T13N-R15E  
Found 1/2 Iron bar in gravel Road Bed

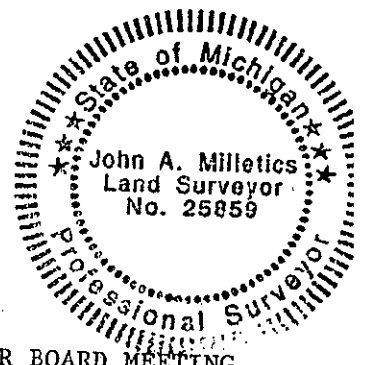

APPROVED PEER BOARD MEETING  
12-02-96 *JM*

C. Description of monument for corner and accessories established to perpetuate locating the position of the corner:

- D-13 S 1/4 Corner Section 32 T13N-R15E  
1/2" Iron Bar in gravel Road Bed  
S45°W 191.37 feet to a nail in a Power Pole  
S40°E 268.57 feet to a nail in a Power Pole  
West 2657.24 feet to the SW Corner Section 32  
East 2657.24 feet to the SE Corner Section 32
- E-13 SE Corner Section 32 T13N=R15E  
1/2 Iron Bar in Gravel Road bed  
N50°E 42.90 feet to the West leg of a Road Sign  
S45°W 74.00 to a stop sign  
S05°W 146.80 feet to a nail in a Power Pole  
West 2657.24 feet to the S 1/4 Cor Section 32

Signed by *John A. Milletics*  
Surveyor's Michigan License No. 25859

Date Aug 24, 1996