

MAY 07 1996

2 PAGE 36

REMONUMENTATION

RECEIVED FOR RECORD

COMMISSION

LAND CORNER RECORDATION CERTIFICATE
Filing Requirement of Act 74, Mich. P.A. 1970

96 DEC 10 AM 11:56

LIBER NO. 2 PAGE NO. 96
ESTHER LEE
REGISTER OF DEEDS
SANILAC CO. MICHIGAN

For corners in

Sanilac (County)	Located In:	Corner Code #
1. Public Land Survey	T13N R15E	D-13, E-13
	T___ R___	_____
	T___ R___	_____
	T___ R___	_____
2. Property Controlling In Section	S___ T___ R___	_____
	S___ T___ R___	_____
3. Miscellaneous Property in Sec.	S___ T___ R___	_____
	S___ T___ R___	_____
4. Lot No. _____, Recorded Plat _____		
5. Private Claims _____		

Register of Deeds Stamp & File Number

I, John A Milletics, in a field survey on June 8, 1996 do hereby state that under requirements of P.A. 74, Michigan P.A. of 1970, the corner points mentioned in lines 1 and 2 above were in conformance with regulations and rules therefore as required in the current manual of survey instructions of the United States Department of the Interior, Bureau of Land Management or by a decree of a Court of Law and for that the corner points mentioned in lines 3, 4 and 5 above were in conformance with the rules of the Michigan Board of Land Surveyors or by a Decree of a Court of Law; established, re-established, monumented, recovered, found as expressed below:

NOTE: Not more than 2 corners, all in the same town and range, may be recorded on this certificate.


	A	B	C	D	E	F	G	H	I	J	K	L	M
1													
2	6		5		4		3		2		1		
3													
4	7		8		9		10		11		12		
5													
6	18		17		16		15		14		13		
7													
8	19		20		21		22		23		24		
9													
10	30		29		28		27		26		25		
11													
12	31		32		33		34		35		36		
13													

A. Description of original monument and accessories and/or subsequent restoration:

- D - 13 GLO Notes
40.00 Set 1/4 Section Post
Hemlock 18 N73 1/2 E 19
Hemlock 9 N71 W 41
No Survey in Old Liber
No Act 74, No act 132
No Road Comm or Drain Co. Notes
Old Plat recorded Liber 1 Page 27 1884
- E - 13 GLO Notes
80.00 Set Post Corner
Hemlock 14 N74 E 8
Hemlock 20 N68 W 60
No Survey in Old Liber
NO Act 132, No act 74
Road Comm shows found iron bar

B. Description of corner evidence found and/or method applied in restoring or reestablishing corner.

- D - 13
S 1/4 Cor Section 32 T13N-R15E
Set 1/2 Iron Bar at half distance
checks with plat as recorded Liber 1 Page 27
- E - 13
SE Cor Section 32 T13N-R15E
Found 1/2 Iron bar in gravel Road Bed

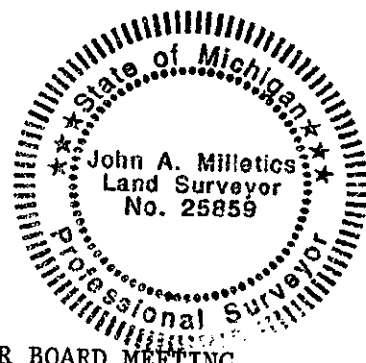

APPROVED PEER BOARD MEETING
12-02-96 JM

C. Description of monument for corner and accessories established to perpetuate locating the position of the corner:

- | | |
|---|---|
| D-13 | E-13 |
| S 1/4 Corner Section 32 T13N-R15E | SE Corner Section 32 T13N-R15E |
| 1/2" Iron Bar in gravel Road Bed | 1/2 Iron Bar in Gravel Road bed |
| S45°W 191.37 feet to a nail in a Power Pole | N50°E 42.90 feet to the West leg of a Road Sign |
| S40°E 268.57 feet to a nail in a Power Pole | S45°W 74.00 to a stop sign |
| West 2657.24 feet to the SW Corner Section 32 | S05°W 146.80 feet to a nail in a Power Pole |
| East 2657.24 feet to the SE Corner Section 32 | West 2657.24 feet to the S 1/4 Cor Section 32 |

Signed by [Signature]
Surveyor's Michigan License No. 25859

Date Aug 24, 1996