

MAY 07 1997  
LIBER

2 PAGE 97

RECEIVED FOR RECORD

96 DEC 10 AM 11:56

COMMISSION

REMONUMENTATION  
LAND CORNER RECORDATION CERTIFICATE  
Filing Requirement of Act 74, Mich. P.A. 1970

LIBER NO. 2 PAGE NO. 97  
ESTHER LEE  
REGISTER OF DEEDS  
SANILAC CO., MICHIGAN

For corners in Sanilac (County) Located In: Corner Code #

1. Public Land Survey	T 13N R 15E	F-13 G-13
	T _____ R _____	_____
	T _____ R _____	_____
	T _____ R _____	_____
2. Property Controlling in Section	S _____ T _____ R _____	_____
	S _____ T _____ R _____	_____
3. Miscellaneous Property in Sec.	S _____ T _____ R _____	_____
	S _____ T _____ R _____	_____
4. Lot No. _____, Recorded Plat _____		
5. Private Claims _____		

Register of Deeds Stamp & File Number


I, John A. Millettics, in a field survey on June 9, 1996, do hereby certify that under requirements of P.A. 74, Michigan P.A. of 1970, the corner points mentioned in lines 1 and 2 above were in conformance with regulations and rules therefore as required in the current manual of survey instructions of the United States Department of the Interior, Bureau of Land Management or by a decree of a Court of Law and/or that the corner points mentioned in lines 3, 4 and 5 above were in conformance with the rules of the Michigan Board of Land Surveyors or by a Decree of a Court of Law; established, re-established, monumented, re-monumented, recovered, found as expressed below:

A	B	C	D	E	F	G	H	I	J	K	L	M
2	6	5	4	3	2	1						
3												
4	7	8	9	10	11	12						
5												
6	18	17	16	15	14	13						
7												
8	19	20	21	22	23	24						
9												
10	30	29	28	27	26	25						
11												
12	31	32	33	34	35	36						
13												

NOTE: Not more than 4 corners, all in the same town and range, may be recorded on this certificate.

- A. Description of original monument and accessories and/or subsequent restoration:
- F - 13 GLO Notes No Old Survey Liber  
40.00 Set 1/4 Section Post No Act 132, No Act 74  
Beech 12 N87E 23 No Road Comm or Drain Comm Notes  
Beech 20 N25W 44 Section Breck Down on unrecorded survey dated 4-28-94
  - G - 13 GLO Notes No Old Survey Liber  
80.00 Set Post Corner No Act 132 - No Act 74  
Hemlock 14 N89E 33 No Road Comm or Drain Comm Notes  
Hemlock 11 N73W 24 1/2 Section Breck down on unrecorded survey dated 4-28-96

- B. Description of corner evidence found and/or method applied in restoring or reestablishing corner:
- F - 13 S 1/4 Corner Section 33 T13N-R15E  
Found 1/2" iron bar in gravel road bed set on line between SE and SW Cor at 1/2 distance
  - G - 13  
SE Corner Section 33 T13N-R15E  
Found 3/4" Pipe in gravel Road Bed 14.52 feet west of 1/2" Iron Bar GLO offset

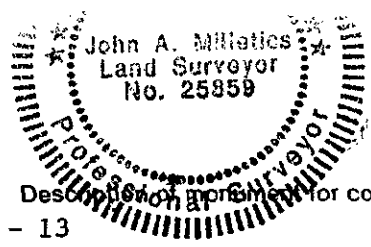

APPROVED PEER BOARD MEETING  
12-02-96 JM

- C. Description of monuments for corner and accessories established to perpetuate locating the position of the corner:
- |   |  |
|---|--|
| F - 13  | G - 13                                     |
| S 1/4 Corner Section 33 T13N-R15E               | SE Corner Section 33 T13N-R15E             |
| 1/2" iron bar 6 feet north of gravel centerline | 3/4" iron pipe in gravel Road Bed          |
| East 24.40 feet to a 1/2" Iron Bar              | East 14.52 feet to a 1/2" Iron Bar         |
| S20°E 72.30 feet to a nail in a Fence Post      | N45°W 46.70 feet to a nail in a Tele Pole  |
| S30°E 43.09 feet to a nail in a Fence Post      | S45°W 36.80 feet to a nail in a Fence Post |
| West 2641.40 feet to the SW Corner Section 33   | S45°E 80.90 feet to a nail in a Power Pole |
| East 2641.40 feet to the SE Corner Section 33   | N45°E 44.40 feet to a metal cable post     |

Signed by John A. Millettics Date Aug 25, 1996  
Surveyor's Michigan License No. 25859