

**SURVEY & REMONUMENTATION**

MAY 07 1997

LIBER 2 PAGE 38

REMONUMENTATION

**LAND CORNER RECORDATION CERTIFICATE**  
Filing Requirement of Act 74, Mich. P.A. 1970

RECEIVED FOR RECORD

96 DEC 10 AM 11:56

LIBER NO. 2 PAGE NO. 38  
ESTHER LEE  
REGISTER OF DEEDS  
SAHILAC CO., MICHIGAN

For corners in

Sanilac (County)	Located In:	Corner Code #
1. Public Land Survey	T 13NR 15E	H-13 - I-13
	T ___ R ___	_____
	T ___ R ___	_____
	T ___ R ___	_____
2. Property Controlling In Section	S ___ T ___ R ___	_____
	S ___ T ___ R ___	_____
3. Miscellaneous Property in Sec.	S ___ T ___ R ___	_____
	S ___ T ___ R ___	_____
4. Lot No. _____, Recorded Plat _____		
5. Private Claims _____		

Register of Deeds Stamp & File Number

A	B	C	D	E	F	G	H	I	J	K	L	M
1												
2	6	5	4	3	2	1						
3												
4	7	8	9	10	11	12						
5												
6	18	17	16	15	14	13						
7												
8	19	20	21	22	23	24						
9												
10	30	29	28	27	26	25						
11												
12	31	32	33	34	35	36						
13												

I, JOHN A. MILLETICS, in a field survey on June 15, 1996 do hereby state that under requirements of P.A. 74, Michigan P.A. of 1970, the corner points mentioned in lines 1 and 2 above were in conformance with regulations and rules therefore as required in the current manual of survey instructions of the United States Department of the Interior, Bureau of Land Management or by a decree of a Court of Law and/or that the corner points mentioned in lines 3, 4 and 5 above were in conformance with the rules of the Michigan Board of Land Surveyors or by a Decree of a Court of Law; established, re-established, monumented, recovered, found as expressed below:

NOTE: Not more than 2 corners, all in the same town and range, may be recorded on this certificate.

**A. Description of original monument and accessories and/or subsequent restoration:**

- H-13 GLO Notes No Old Survey Liber  
40.00 Set 1/4 Section Post No Act 74  
B. Ash 24 N63W 29 Act 132 Liber 3 Page 781 Dunn Const.  
Hemlock 12 N36E 50 No Road Comm or Drain Comm Notes
- I-13 GLO Notes No Old Survey Liber  
80.00 Set Post Corner No Act 74  
Beech 10 N80°E 40 No Act 132, No Road Comm or Drain Comm Notes  
Beech 12 N78°W 14 Unrecorded survey dated 12-13-89

**B. Description of corner evidence found and/or method applied in restoring or reestablishing corner:**


- H - 13  
S 1/4 Corner Section 34 T13N-R15E  
Found 5/8" Iron bar in gravel road bed as per Liber 3 Page 781
- I - 13  
SE Corner Section 34 T13N-R15E  
Found 1/2 Iron bar in gravel Road Bed on centerline of pavement to North  
as per survey dated 12-13-89

APPROVED PEER BOARD MEETING

12-02-96 97

**C. Description of monument for corner and accessories established to perpetuate locating the position of the corner:**

- H-13  
S1/4 Cor Section 34 T13N-R15E  
5/8" Iron Bar in gravel Road Bed  
North 35.00 feet to a nail in a 18" Ash  
N20°E 28.85 feet to a Bell Box  
N50°E 39.10 feet to a nail in a 36" Maple  
S50°E 86.25 feet to a nail in a Power Pole  
West 2658.16 feet to the SW Cor Sec. 34
- I-13  
SE Corner Section 34 T13N-R15E  
1/2" Iron Bar in gravel Road Bed  
N50°E 44.00 feet to a Stop Sign  
N40°W 43.90 feet to a Road Sign  
S50°W 42.05 feet to a Stop Sign  
S45°E 91.30 feet to a nail in a Power Pole  
N50°W 57.75 feet to a Bell Box  
West 2645.60 feet to the S1/4 Cor Sec. 34

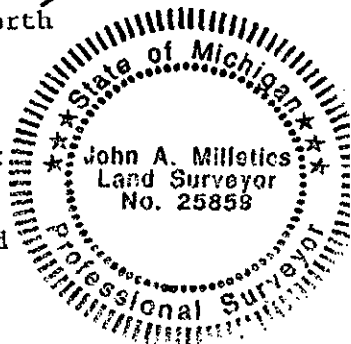

Signed by [Signature]  
Surveyor's Michigan License No. 25859

Date Aug 28, 1996