

REMONUMENTATION

LAND CORNER RECORDATION CERTIFICATE

Filing Requirement of Act 74, Mich. P.A. 1970

RECEIVED FOR RECORD

98 DEC -1 AM 9:08

LIBER NO. 2 PAGE NO. 226

For corners in

Sanilac

(County)

Located In:

Corner Code #

1. Public Land Survey

T13N R16E

A-4

T R

T R

T R

2. Property Controlling in Section

S T R

3. Miscellaneous Property in Sec.

S T R

S T R

S T R

4. Lot No. , Recorded Plat

5. Private Claims

MICHELE VANNORMAN REGISTER OF DEEDS SANILAC CO., MICHIGAN

Register of Deeds Stamp & File Number

	A	B	C	D	E	F	G	H	I	J	K	L	M
1													
2	6	5	4	3	2	1							
3													
4	7	8	9	10	11	12							
5													
6	18	17	16	15	14	13							
7													
8	19	20	21	22	23	24							
9													
10	30	29	28	27	26	25							
11													
12	31	32	33	34	35	36							
13													

I, John A. Milletics, in a field survey on Oct 25, 1998 do hereby state that under requirements of P.A. 74, Michigan P.A. of 1970, the corner points mentioned in lines 1 and 2 above were in conformance with regulations and rules therefore as required in the current manual of survey instructions of the United States Department of the Interior, Bureau of Land Management or by a decree of a Court of Law and/or that the corner points mentioned in lines 3, 4 and 5 above were in conformance with the rules of the Michigan Board of Land Surveyors or by a Decree of a Court of Law; established, re-established, monumented, recovered, found as expressed below:

NOTE: Not more than 2 corners, all in the same town and range, may be recorded on this certificate.


SURVEY & REMONUMENTATION

JAN 15 1999

SECTION

APPROVED PEER BOARD MEETING NOV 30, 1998

Signature

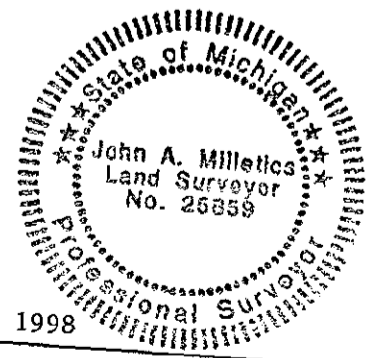

A. Description of original monument and accessories and/or subsequent restoration:

A-4 GLO Notes - Hemlock 11 S43W 27 1/2; B. Ash 11 N31W 43 Old Survey Liber - Survey br J.W. Galbraith dated 1891 L.C.R.C. - None Act 132 - None Road Comm - None Unrecorded Survey dates 6-30-97

B. Description of corner evidence found and/or method applied in restoring or reestablishing corner:

A-4 W 1/4 Corner Section 7 T13N-R16E Found 1/2" Iron bar on line with the SE and SW Corner of Section at half distance. Accepted as best evidence

C. Description of monument for corner and accessories established to perpetuate locating the position of the corner:

A-4 W 1/4 Corner Section 7 T13N-R16E 1/2" Iron Bar with cap North 2649.32 feet to the NW Corner Section 7 South 2649.32 feet to the SW Corner Section 7 S70°E 69.10 feet to a nail in a Power Pole East 13.00 feet to the centerline of a gravel road N20°W 36.00 feet to a nail in a 12" Ash S10°W 12.30 feet to a nail in a 9" Ash

Signed by [Signature] Surveyor's Michigan License No. 25859

Date Nov 20, 1998