

RECEIVED FOR RECORD

98 DEC -1 AM 9:08

LIBER NO. 2 PAGE NO. 227

REMONUMENTATION

LAND CORNER RECORDATION CERTIFICATE
Filing Requirement of Act 74, Mich. P.A. 1970

For corners in

<u>Sanilac</u> (County)	Located In:	Corner Code #
1. Public Land Survey	T13N R16E	A-5
	T___ R___	_____
	T___ R___	_____
	T___ R___	_____
2. Property Controlling in Section	S___ T___ R___	_____
	S___ T___ R___	_____
3. Miscellaneous Property in Sec.	S___ T___ R___	_____
	S___ T___ R___	_____

MICHELE VAN NORMAN
REGISTER OF DEEDS
SANILAC CO., MICHIGAN

Register of Deeds Stamp & File Number

4. Lot No. _____, Recorded Plat _____
5. Private Claims _____

I, John A. Milletics, in a field survey on Oct 27, 19 98 do hereby state that under requirements of P.A. 74, Michigan P.A. of 1970, the corner points mentioned in lines 1 and 2 above were in conformance with regulations and rules therefore as required in the current manual of survey instructions of the United States Department of the Interior, Bureau of Land Management or by a decree of a Court of Law and /or that the corner points mentioned in lines 3, 4 and 5 above were in conformance with the rules of the Michigan Board of Land Surveyors or by a Decree of a Court of Law; established, re-established, monumented, recovered, found as expressed below:

NOTE: Not more than 2 corners, all in the same town and range, may be recorded on this certificate.

	A	B	C	D	E	F	G	H	I	J	K	L	M
1													
2	6		5		4		3		2		1		
3													
4	7		8		9		10		11		12		
5													
6	18		17		16		15		14		13		
7													
8	19		20		21		22		23		24		
9													
10	30		29		28		27		26		25		
11													
12	31		32		33		34		35		36		
13													

A. Description of original monument and accessories and/or subsequent restoration:
A-5 GLO Notes - Beech 11 S60W 40; Pine 36 S35W 36
Old Survey Liber - Survey dated 1886 by F.F. Rogers
Survey dated 1891 by J.W. Galbraith
L.C.R.C. - None
Act 132 - Liber 3 , Page 281 - Liber 3 , Page 296

SURVEY &
REMONUMENTATION


JAN 15 1999

SECTION

B. Description of corner evidence found and/or method applied in restoring or reestablishing corner:
A - 5
SW Corner Section 7 T13N-R16E
Found 1/2" Iron Bar in Gravel Road Bed
North 2649.32 feet to the W 1/4 Corner Section 7
South 2644.66 feet to the W 1/4 Corner Section 18
Accepted as best evidence

APPROVED PEER BOARD MEETING
NOV 30, 1998

C. Description of monument for corner and accessories established to perpetuate locating the position of the corner:
A- 5
SW Corner Section 7 T13N-R16E
1/2" Iron Bar in Gravel Road Bed with Cap
North 2649.32 feet to the W 1/4 Corner Section 7
South 2644.66 feet to the W 1/4 Corner Section 18
S45°E 79.00 feet to a nail in a Power Pole
N45°W 42.75 feet to a nail in a Telephone Pole
N70°E 36.25 feet to a Stop Sign
S70°W 38.25 feet to a Stop Sign

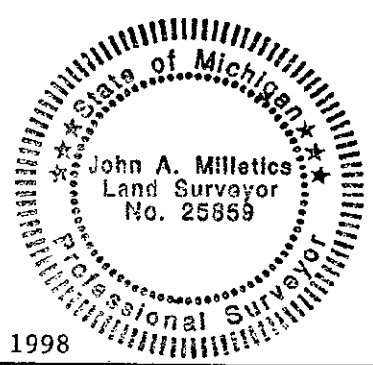

Signed by John A. Milletics
Surveyor's Michigan License No. 25859

Date Nov 20, 1998