

RECEIVED FOR RECORD

REMONUMENTATION

LAND CORNER RECORDATION CERTIFICATE

98 DEC -1 AM 9:08

Filing Requirement of Act 74, Mich. P.A. 1970 LIBER NO. 2 PAGE NO. 228

For corners in

MICHELE VAN NORMAN  
REGISTER OF DEEDS  
SANILAC CO., MICHIGAN

Sanilac (County)	Located in:	Corner Code #
1. Public Land Survey	T13N R16E	A-6
	T R	
	T R	
	T R	
2. Property Controlling in Section	S T R	
	S T R	
3. Miscellaneous Property in Sec.	S T R	
	S T R	

Register of Deeds Stamp & File Number

4. Lot No. \_\_\_\_\_, Recorded Plat \_\_\_\_\_  
5. Private Claims \_\_\_\_\_

I, John A. Milletics, in a field survey on Oct 27, 1998 do hereby state that under requirements of P.A. 74, Michigan P.A. of 1970, the corner points mentioned in lines 1 and 2 above were in conformance with regulations and rules therefore as required in the current manual of survey instructions of the United States Department of the Interior, Bureau of Land Management or by a decree of a Court of Law and /or that the corner points mentioned in lines 3, 4 and 5 above were in conformance with the rules of the Michigan Board of Land Surveyors or by a Decree of a Court of Law; established, re-established, monumented, recovered, found as expressed below:

NOTE: Not more than 2 corners, all in the same town and range, may be recorded on this certificate.

A	B	C	D	E	F	G	H	I	J	K	L	M
1												
2	6		5		4		3		2		1	
3												
4	7		8		9		10		11		12	
5												
6	18		17		16		15		14		13	
7												
8	19		20		21		22		23		24	
9												
10	30		29		28		27		26		25	
11												
12	31		32		33		34		35		36	
13												

A. Description of original monument and accessories and/or subsequent restoration:

A-6 GLO Notes - Sugar 14 S58W 23; Beech 12 N4 1/2W 40  
Old Survey Liber - Survey dated 1886 by F.F. Rogers  
L.C.R.C. - None  
Act 132 - None  
Road Comm - None

SURVEY &  
REMONUMENTATION

JAN 15 1999

SECTION

B. Description of corner evidence found and/or method applied in restoring or reestablishing corner:


A - 6  
W 1/4 Corner Section 18 T13N-R16E  
Set 1/2" Iron Bar with cap on line between the NW Corner and the SW Corner of said section at half distance.

APPROVED PEER BOARD MEETING  
NOV 30, 1998

*JM*

C. Description of monument for corner and accessories established to perpetuate locating the position of the corner:

A - 6  
W 1/4 Corner Section 18 T13N-R16E  
1/2" Iron Bar in gravel road bed with cap  
North 2644.66 feet to the NW Corner Section 18  
South 2644.66 feet to the SW Corner Section 18  
East 51.40 feet to a nail in a Power Pole  
N70°W 32.90 feet to a Bell Box  
East 2.00 feet to the centerline of a gravel road

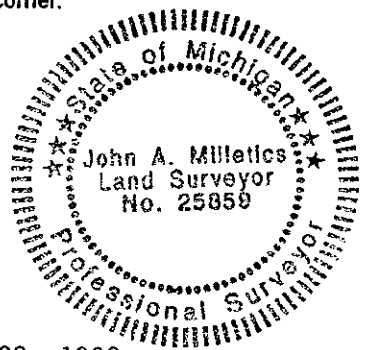

Signed by John A. Milletics  
Surveyor's Michigan License No. 25859

Date Nov 20, 1998