

REMONUMENTATION

LAND CORNER RECORDATION CERTIFICATE
Filing Requirement of Act 74, Mich. P.A. 1970

98 DEC -1 AM 9:08

For corners in

LIBER NO. 2 PAGE NO. 229

Sanilac (County)	Located in:	Corner Code #
1. Public Land Survey	T13N R16E	A-7
	T R	
	T R	
	T R	
2. Property Controlling in Section	S T R	
	S T R	
3. Miscellaneous Property in Sec.	S T R	
	S T R	

MICHELE VANNORMAN
REGISTER OF DEEDS
SANILAC CO., MICHIGAN

Register of Deeds Stamp & File Number

4. Lot No. _____, Recorded Plat _____
5. Private Claims _____

I, John A. Milletics, in a field survey on Oct 27, 19 98 do hereby state that under requirements of P.A. 74, Michigan P.A. of 1970, the corner points mentioned in lines 1 and 2 above were in conformance with regulations and rules therefore as required in the current manual of survey instructions of the United States Department of the Interior, Bureau of Land Management or by a decree of a Court of Law and/or that the corner points mentioned in lines 3, 4 and 5 above were in conformance with the rules of the Michigan Board of Land Surveyors or by a Decree of a Court of Law; established, re-established, monumented, recovered, found as expressed below:

NOTE: Not more than 2 corners, all in the same town and range, may be recorded on this certificate.

	A	B	C	D	E	F	G	H	I	J	K	L	M
1													
2	6		5		4		3		2		1		
3													
4	7		8		9		10		11		12		
5													
6	18		17		16		15		14		13		
7													
8	19		20		21		22		23		24		
9													
10	30		29		28		27		26		25		
11													
12	31		32		33		34		35		36		
13													

A. Description of original monument and accessories and/or subsequent restoration:

A-7 GLO Notes - Hemlock 18 N20W 34; Hemlock 20 S54W 27
Old Survey Liber - Survey dated 1886 by F.F. Rogers
L.C.R.C. - None
Act 132 - Liber 4, Page 115
Unrecorded Survey dated 5-22-90

SURVEY &
REMONUMENTATION

JAN 15 1999

SECTION


B. Description of corner evidence found and/or method applied in restoring or reestablishing corner:

A - 7
SW Corner Section 18 T13N-R16E
Found 1/2" iron bar in gravel road bed
North 2644.66 feet to the W 1/4 Corner Section 18
South 2642.46 feet to the W 1/4 Corner Section 19
Accepted as best evidence

APPROVED PEER BOARD MEETING
NOV 30, 1998

C. Description of monument for corner and accessories established to perpetuate locating the position of the corner:

A-7
SW Corner Section 18 T13N-R16E
1/2" Iron Bar with cap in gravel road bed
North 2644.66 feet to the W 1/4 Corner Section 18
South 2642.46 feet to the W 1/4 Corner Section 19
N45°W 44.75 feet to a nail in a Telephone Pole
S45°E 72.60 feet to a nail in a Power Pole
S45°W 51.10 feet to a Bell Box
N60°E 37.00 feet to a Stop Sign

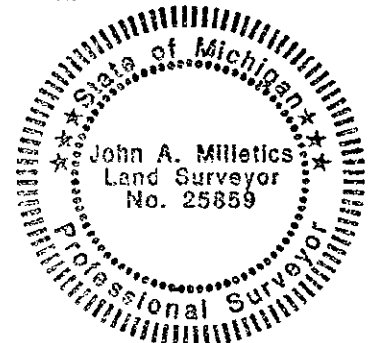

Signed by John A. Milletics
Surveyor's Michigan License No. 25859

Date Nov 20, 1998