

REMONUMENTATION

LAND CORNER RECORDATION CERTIFICATE  
Filing Requirement of Act 74, Mich. P.A. 1970

98 DEC -1 AM 9:08

LIBER NO. 2 PAGE NO. 230

For corners in

Sanilac (County)	Located In:	Corner Code #
1. Public Land Survey	T <u>13N</u> R <u>16E</u>	A-8
	T ___ R ___	_____
	T ___ R ___	_____
	T ___ R ___	_____
2. Property Controlling in Section	S ___ T ___ R ___	_____
	S ___ T ___ R ___	_____
3. Miscellaneous Property in Sec.	S ___ T ___ R ___	_____
	S ___ T ___ R ___	_____

MICHELE VANNORMAN  
REGISTER OF DEEDS  
SANILAC CO., MICHIGAN

Register of Deeds Stamp & File Number

4. Lot No. \_\_\_\_\_, Recorded Plat \_\_\_\_\_  
5. Private Claims \_\_\_\_\_

I, John A. Milletics, in a field survey on Oct 27, 1998 do hereby state that under requirements of P.A. 74, Michigan P.A. of 1970, the corner points mentioned in lines 1 and 2 above were in conformance with regulations and rules therefore as required in the current manual of survey instructions of the United States Department of the Interior, Bureau of Land Management or by a decree of a Court of Law and /or that the corner points mentioned in lines 3, 4 and 5 above were in conformance with the rules of the Michigan Board of Land Surveyors or by a Decree of a Court of Law; established, re-established, monumented, recovered, found as expressed below:

NOTE: Not more than 2 corners, all in the same town and range, may be recorded on this certificate.

	A	B	C	D	E	F	G	H	I	J	K	L	M
1													
2		6		5		4		3		2		1	
3													
4		7		8		9		10		11		12	
5													
6		18		17		16		15		14		13	
7													
8		19		20		21		22		23		24	
9													
10		30		29		28		27		26		25	
11													
12		31		32		33		34		35		36	
13													

A. Description of original monument and accessories and/or subsequent restoration:

A-8 GLO Notes - Cedar 9 N27W 15 1/2; Pine 10 S2W 22  
Old Survey Liber - Survey by F.F. Roger dated 1886  
L.C.R.C. - None  
Act 132 - Liber 4, Page 115  
Road Comm - None

SURVEY &  
REMONUMENTATION

JAN 15 1999

B. Description of corner evidence found and/or method applied in restoring or reestablishing corner:


SECTION

A - 8  
W 1/4 Corner Section 19 T13N-R16E  
Found 1/2" Iron Bar on line between the SW Corner and the NW Corner of said section at half distance.  
Accepted as best evidence  
North 2642.46 feet to the NW Corner Section 19  
South 2642.46 feet to the SW Corner Section 19

APPROVED PEER BOARD MEETING  
NOV 30, 1998

C. Description of monument for corner and accessories established to perpetuate locating the position of the corner:

A - 8  
W 1/4 Corner Section 19 T13N-R16E  
1/2" iron bar with cap in gravel road bed  
North 2642.46 feet to the NW Corner Section 19  
South 2642.46 feet to the SW Corner Section 19  
East 51.50 feet to a nail in a Power Pole  
East 6.00 feet to the centerline of a gravel road  
N30°W 52.80 feet to a nail in a 24" Maple Tree  
N35°W 99.35 feet to a nail in a 24" Maple Tree

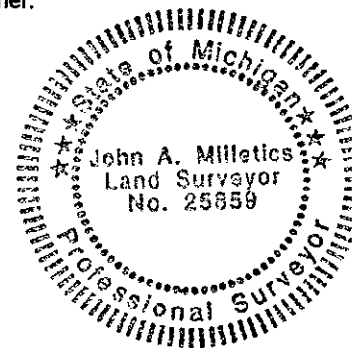

Signed by John A. Milletics  
Surveyor's Michigan License No. 25859

Date Nov 20, 98