

98 DEC -1 AM 9:08

REMONUMENTATION

LAND CORNER RECORDATION CERTIFICATE

Filing Requirement of Act 74, Mich. P.A. 1970 LIBER NO. 2 PAGE NO. 233

For corners in

Sanilac

(County)

Located in:

Corner Code #

- 1. Public Land Survey T13N R16E A-11
T R
T R
T R
- 2. Property Controlling in Section S T R
S T R
- 3. Miscellaneous Property in Sec. S T R
S T R

MICHELE VANNORMAN
REGISTER OF DEEDS
SANILAC CO., MICHIGAN

Register of Deeds Stamp & File Number

- 4. Lot No. _____, Recorded Plat _____
- 5. Private Claims _____

I, John A. Milletics, in a field survey on Oct 27, 1998 do hereby state that under requirements of P.A. 74, Michigan P.A. of 1970, the corner points mentioned in lines 1 and 2 above were in conformance with regulations and rules therefore as required in the current manual of survey instructions of the United States Department of the Interior, Bureau of Land Management or by a decree of a Court of Law and/or that the corner points mentioned in lines 3, 4 and 5 above were in conformance with the rules of the Michigan Board of Land Surveyors or by a Decree of a Court of Law; established, re-established, monumented, recovered, found as expressed below:

NOTE: Not more than 2 corners, all in the same town and range, may be recorded on this certificate.

	A	B	C	D	E	F	G	H	I	J	K	L	M
1													
2	6		5		4		3		2		1		
3													
4	7		8		9		10		11		12		
5													
6	18		17		16		15		14		13		
7													
8	19		20		21		22		23		24		
9													
10	30		29		28		27		26		25		
11													
12	31		32		33		34		35		36		
13													

A. Description of original monument and accessories and/or subsequent restoration:

- A-11 GLO Notes - Sugar 10 S49W 53; Hemlock 18 N58W 21
- Old Survey Liber - None
- Act 132 - None
- L.C.R.C. - None
- Unrecorded Surveys - Dated 12-10-69(Collins) - 7-26-78(KAY)

SURVEY & REMONUMENTATION

JAN 15 1999

SECTION


B. Description of corner evidence found and/or method applied in restoring or reestablishing corner:

- A - 11
- SW Corner Section 30 T13N-R16E
- Found Monu Box with 1/2" Iron Bar in
- North 2636.22 feet to the W 1/4 Corner Section 30
- South 2640.60 feet to the W 1/4 Corner Section 31
- Accepted as best evidence

APPROVED PEER BOARD MEETING
NOV 30, 1998

C. Description of monument for corner and accessories established to perpetuate locating the position of the corner:

- A - 11
- SW Corner Section 30 T13N-R16E
- Monu Box with 1/2" iron in with cap
- North 2632.22 feet to the W 1/4 Corner Section 30
- South 2640.60 feet to the W 1/4 Corner Section 31
- N45°E 54.90 feet to the South Leg of a Road Sign
- S45°W 63.15 feet to the North Leg of a Road Sign
- S45°E 70.50 feet to a nail in a Power Pole
- N45°W 47.00 feet to a Bell Box

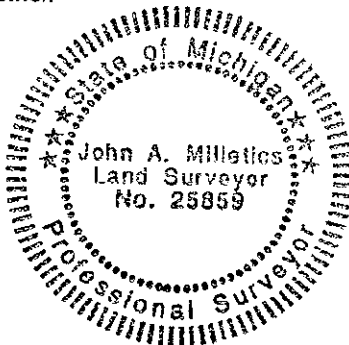

Signed by John A. Milletics
Surveyor's Michigan License No. 25859

Date Nov 20, 1998