

RECEIVED FOR RECORD

98 DEC -1 AM 9:08

LIBER NO. 2 PAGE NO. 234

REMONUMENTATION

LAND CORNER RECORDATION CERTIFICATE  
Filing Requirement of Act 74, Mich. P.A. 1970

For corners in

Sanilac (County)	Located In:	Corner Code #
1. Public Land Survey	T13N R16E	A-12
	T R	
	T R	
	T R	
2. Property Controlling in Section	S T R	
	S T R	
3. Miscellaneous Property in Sec.	S T R	
	S T R	

MICHELE VANNORMAN  
REGISTER OF DEEDS  
SANILAC CO., MICHIGAN

Register of Deeds Stamp & File Number

- 4. Lot No. \_\_\_\_\_, Recorded Plat \_\_\_\_\_
- 5. Private Claims \_\_\_\_\_

I, John A. Milletics, in a field survey on Oct 27, 1998 do hereby state that under requirements of P.A. 74, Michigan P.A. of 1970, the corner points mentioned in lines 1 and 2 above were in conformance with regulations and rules therefore as required in the current manual of survey instructions of the United States Department of the Interior, Bureau of Land Management or by a decree of a Court of Law and /or that the corner points mentioned in lines 3, 4 and 5 above were in conformance with the rules of the Michigan Board of Land Surveyors or by a Decree of a Court of Law; established, re-established, monumented, recovered, found as expressed below:

NOTE: Not more than 2 corners, all in the same town and range, may be recorded on this certificate.

	A	B	C	D	E	F	G	H	I	J	K	L	M
1													
2	6		5		4		3		2		1		
3													
4	7		8		9		10		11		12		
5													
6	18		17		16		15		14		13		
7													
8	19		20		21		22		23		24		
9													
10	30		29		28		27		26		25		
11													
12	31		32		33		34		35		36		
13													

A. Description of original monument and accessories and/or subsequent restoration:

- A-12 GLO Notes - Hemlock 10 S60W 26; Beech 8 N31W 55
- Old Survey Liber - None
- Act 132 - None
- L.C.R.C. - None
- Unrecorded surveys - Huron Surveying Dated 4-29-98- Collins Survey dated 12-10-69
- Road Comm - None

B. Description of corner evidence found and/or method applied in restoring or reestablishing corner:

- A - 12
- W 1/4 Corner Section 31 T13N-R16E
- Found 1/2" Iron Bar in Gravel Road Bed
- North 2640.60 feet to the NW Corner Section 31
- South 2645.24 feet to the SW Corner Section 31
- Accepted as best evidence

SURVEY & REMONUMENTATION


JAN 15 1999

SECTION

APPROVED PEER BOARD MEETING  
NOV 30, 1998

C. Description of monument for corner and accessories established to perpetuate locating the position of the corner:

- A - 12
- W 1/4 Corner Section 31 T13N-R16E
- 1/2" iron Bar in Gravel Road Bed with cap
- North 2640.60 feet to the NW Corner Section 31
- South 2645.24 feet to the SW Corner Section 31
- East 45.90 feet to a nail in a 10" Maple Tree
- S50°E 43.15 feet to a nail in a 10 Poplar
- West 30.45 feet to a Bell Box
- S60°W 37.90 feet to a nail in a 10 Poplar

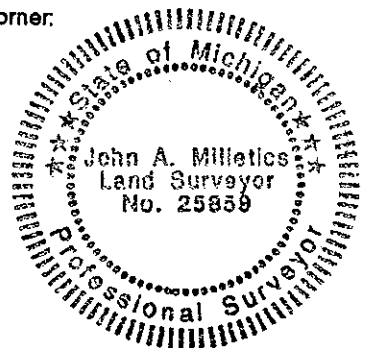

Signed by John A. Milletics  
Surveyor's Michigan License No. 25859

Date Nov 20, 1998