

Remonumentation

LAND CORNER RECORDATION CERTIFICATE
Filing Requirement of Act 74, Mich. P.A. 1970

RECEIVED FOR RECORD

95 JUL 10 AM 9:27

LIBER NO. 2 PAGE NO. 56
ESTHER LEE
REGISTER OF DEEDS
SANILAC CO., MICHIGAN

For comers in
Sanilac
(County)

Located In: Corner Code #/

1. Public Land Survey	T	<u>14^N</u>	R	<u>12^E</u>	C - 11	C - 12
	T		R			
	T		R			
	T		R			
2. Property Controlling in Section	S		T	R		
	S		T	R		
3. Miscellaneous Property in Sec.	S		T	R		
	S		T	R		

Register of Deeds Stamp & File Number

- 4. Lot No. _____, Recorded Plat _____
- 5. Private Claims _____

	A	B	C	D	E	F	G	H	I	J	K	L	M
2	6	5	4	3	2	1							
3													
4	7	8	9	10	11	12							
5													
6	18	17	16	15	14	13							
7													
8	19	20	21	22	23	24							
9													
10	30	29	28	27	26	25							
11													
12	31	32	33	34	35	36							
13													

I, John A Milletics, in a field survey on May 5, 1995, do hereby certify that under requirements of P.A. 74, Michigan P.A. of 1970, the corner points mentioned in lines 1 and 2 above were in conformance with regulations and rules therefore as required in the current manual of survey instructions of the United States Department of the Interior, Bureau of Land Management or by a decree of a Court of Law and/or that the corner points mentioned in lines 3, 4 and 5 above were in conformance with the rules of the Michigan Board of Land Surveyors or by a Decree of a Court of Law; established, re-established, monumented, re-monumented, recovered, found as expressed below:

NOTE: Not more than 4 corners, all in the same town and range, may be recorded on this certificate.

A. Description of original monument and accessories and/or subsequent restoration:
C-11 GLO Notes

Set Post Beech 22 N67°E 40 - Hemloch 14 N61°W 29

Act 74 Form Liber 1 Page 362 Act 132 Forms Liber 3 Page - Liber 3 Page 293

Road Comm. None Drain Comm None, State Highway Right of Way Book Page 11

C - 12 GLO Notes

Set Post at 40 Chains Cedar 8 S48W 8 - Cedar 6 N13°W 28

Act 74 Form None Act 132 Form Liber 3 Page 293 State Highway Right of Way book Page 11

Road Comm None, Drain Comm None

B. Description of corner evidence found and/or method applied in restoring or reestablishing corner:

C - 11

Found Monu Box in Place

NE Cor Section 31 T14N-R12E

Approved Peer Group Meeting May 25, 1995

C - 12

Found P.K Nail

E 1/4 Cor Section 31 T14N-R12E

SURVEY & REMONUMENTATION

JUL 3 1 1995

COMMISSION

C. Description of monument for corner and accessories established to perpetuate locating the position of the corner:

C-11

NE Cor Section 31 T14N-R12E

Monu Box

N45°E 74.28 to a nail in a Power Pole

S45°E 69.60 to a nail in a Power Pole

S45°W 67.80 a R/R spike in a Power Pole

East 1.20 to the centerline of pavement

C - 12

E 1/4 Cor Section 31 T14N-R12E

Monu Box

S80°W 51.28 to a nail in a 18" Ash


East 64.48' to a nail in top of Fence Post

S70°E 71.14 to a nail in a Power Pole

East 4.3' to the centerline of pavement

Signed by John A Milletics

Surveyor's Michigan License No. 25859

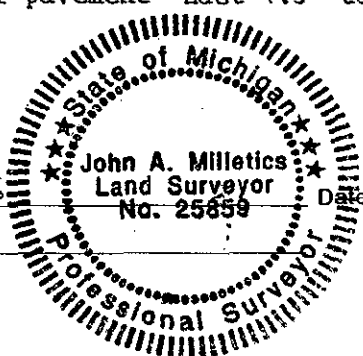

May 22, 1995