

REMONUMENTATION

LAND CORNER RECORDATION CERTIFICATE  
Filing Requirement of Act 74, Mich. P.A. 1970

RECEIVED FOR RECORD

98 DEC -1 AM 9:10

LIBER NO. 2 PAGE NO. 280

MICHELE VANNORMAN  
REGISTER OF DEEDS  
SANILAC CO., MICHIGAN

For corners in

Sanilac (County)	Located In:	Corner Code #
1. Public Land Survey	T14N R12E	J-13
	T R	
	T R	
	T R	
2. Property Controlling in Section	S T R	
	S T R	
3. Miscellaneous Property in Sec.	S T R	
	S T R	

Register of Deeds Stamp & File Number

4. Lot No. \_\_\_\_\_, Recorded Plat \_\_\_\_\_  
5. Private Claims \_\_\_\_\_

I, John A. Millettics, in a field survey on Nov 1, 19 98 do hereby state that under requirements of P.A. 74, Michigan P.A. of 1970, the corner points mentioned in lines 1 and 2 above were in conformance with regulations and rules therefore as required in the current manual of survey instructions of the United States Department of the Interior, Bureau of Land Management or by a decree of a Court of Law and/or that the corner points mentioned in lines 3, 4 and 5 above were in conformance with the rules of the Michigan Board of Land Surveyors or by a Decree of a Court of Law; established, re-established, monumented, recovered, found as expressed below:

NOTE: Not more than 2 corners, all in the same town and range, may be recorded on this certificate.


	A	B	C	D	E	F	G	H	I	J	K	L	M
1													
2	6		5		4		3		2		1		
3													
4	7		8		9		10		11		12		
5													
6	18		17		16		15		14		13		
7													
8	19		20		21		22		23		24		
9													
10	30		29		28		27		26		25		
11													
12	31		32		33		34		35		36		
13													

A. Description of original monument and accessories and/or subsequent restoration:

J-13 GLO Notes - Hemlock 26 N70W 4; Beech 10 N67E 27  
Old Survey Liber - None  
L.C.R.C. - None  
Act 132 - None  
Road Comm - None

B. Description of corner evidence found and/or method applied in restoring or reestablishing corner:

J - 13  
S 1/4 Corner Section 35 T14N-R12E  
Found 1/2 Iron Bar at half distance between  
the SE corner and the SW corner of said Section  
Accepted as best evidence

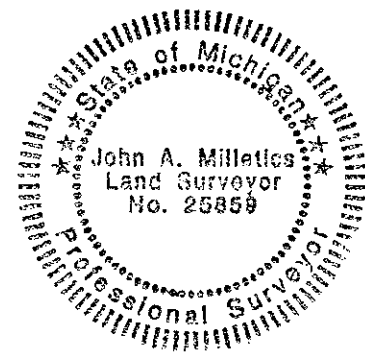

APPROVED PEER BOARD MEETING  
NOV 30, 1998

C. Description of monument for corner and accessories established to perpetuate locating the position of the corner:

J - 13  
S 1/4 Corner Section 35 T14N-R12E  
1/2" Iron Bar with Cap  
West 2660.70 feet to the SW Corner Section 35  
East 2660.70 feet to the SE Corner Section 35  
S45°W 53.60 feet to a nail in a 8" Ash  
South 33.00 feet to a 1/2" iron bar  
North 33.00 feet to a 1/2" iron bar

SURVEY &  
REMONUMENTATION

JAN 15 1999

SECTION

Signed by John A. Millettics  
Surveyor's Michigan License No. 25859

Date Nov 20, 1998