

RECEIVED FOR RECORD

98 DEC -1 AM 9:10

REMONUMENTATION

LAND CORNER RECORDATION CERTIFICATE
Filing Requirement of Act 74, Mich. P.A. 1970

For corners in

Sanilac (County)	Located In:	Corner Code #
1. Public Land Survey	T14NR12E	K-13
	T R	
	T R	
	T R	
2. Property Controlling in Section	S T R	
	S T R	
3. Miscellaneous Property in Sec.	S T R	
	S T R	

LIBER NO. 2 PAGE NO. 281
MICHELE VANNORMAN
REGISTER OF DEEDS
SANILAC CO., MICHIGAN

Register of Deeds Stamp & File Number

4. Lot No. _____, Recorded Plat _____
5. Private Claims _____

I, John A. Milletics, in a field survey on Nov 1, 1998 do hereby state that under requirements of P.A. 74, Michigan P.A. of 1970, the corner points mentioned in lines 1 and 2 above were in conformance with regulations and rules therefore as required in the current manual of survey instructions of the United States Department of the Interior, Bureau of Land Management or by a decree of a Court of Law and/or that the corner points mentioned in lines 3, 4 and 5 above were in conformance with the rules of the Michigan Board of Land Surveyors or by a Decree of a Court of Law; established, re-established, monumented, recovered, found as expressed below:

NOTE: Not more than 2 corners, all in the same town and range, may be recorded on this certificate.


	A	B	C	D	E	F	G	H	I	J	K	L	M	
1														
2	6			5			4			3			2	1
3														
4	7			8			9			10			11	12
5														
6	10			17			16			15			14	13
7														
8	19			20			21			22			23	24
9														
10	30			29			28			27			26	25
11														
12	31			32			33			34			35	36
13														

A. Description of original monument and accessories and/or subsequent restoration:

K-13 GLO Notes - Sugar 20 N85E 15 1/2; Ironwood 10 N72 1/2W 11
Old Survey Liber - None
Act 132 - Liber 3, Page 177 (CASE)
Liber 4, Page 365 (CASE)
L.C.R.C. - None
Road Comm - None

B. Description of corner evidence found and/or method applied in restoring or reestablishing corner:

K - 13
SE Corner Section 35 T14N-R12E
Found Monu Box with 5/8" Pin in Box
West 2660.70 feet to the S 1/4 Corner Section 35
East 2642.32 feet to the S 1/4 Corner Section 36
Accepted as best evidence

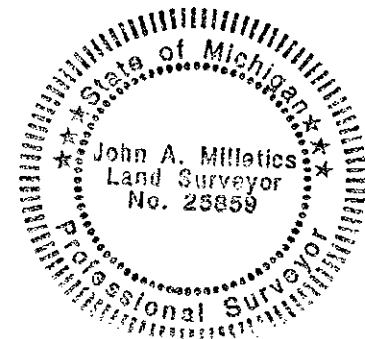

APPROVED PEER BOARD MEETING
NOV 30, 1998

C. Description of monument for corner and accessories established to perpetuate locating the position of the corner:

K - 13
SE Corner Section 35 T14N-R12E
Monu Box with 5/8" Pin in Box
West 2660.70 feet to the S 1/4 Corner Section 35
East 2642.32 feet to the S 1/4 Corner Section 36
S45°E 56.00 feet to a nail in a Power Pole
West 9.00 feet to the centerline of pavement
S55°W 48.80 feet to a Stop Sign
N30°W 66.20 feet to a Bell Box

SURVEY &
REMONUMENTATION
JAN 15 1999
SECTION

Signed by John A. Milletics
Surveyor's Michigan License No. 25859

Date Nov 20, 1998