

RECEIVED FOR RECORD

98 DEC -1 AM 9:10

REMONUMENTATION

LAND CORNER RECORDATION CERTIFICATE  
Filing Requirement of Act 74, Mich. P.A. 1970

LIBER NO. 2 PAGE NO. 282

For corners in

Sanilac (County)	Located In:	Corner Code #
1. Public Land Survey	T14N R12E	L-13
	T R	
	T R	
	T R	
2. Property Controlling in Section	S T R	
	S T R	
3. Miscellaneous Property in Sec.	S T R	
	S T R	

MICHELE VANNORMAN  
REGISTER OF DEEDS  
SANILAC CO., MICHIGAN

Register of Deeds Stamp & File Number

4. Lot No. \_\_\_\_\_, Recorded Plat \_\_\_\_\_  
5. Private Claims \_\_\_\_\_

I, John A. Milletics, in a field survey on Nov 1, 1998 do hereby state that under requirements of P.A. 74, Michigan P.A. of 1970, the corner points mentioned in lines 1 and 2 above were in conformance with regulations and rules therefore as required in the current manual of survey instructions of the United States Department of the Interior, Bureau of Land Management or by a decree of a Court of Law and/or that the corner points mentioned in lines 3, 4 and 5 above were in conformance with the rules of the Michigan Board of Land Surveyors or by a Decree of a Court of Law; established, re-established, monumented, recovered, found as expressed below:

NOTE: Not more than 2 corners, all in the same town and range, may be recorded on this certificate.


	A	B	C	D	E	F	G	H	I	J	K	L	M
1													
2	6		5		4		3		2		1		
3													
4	7		8		9		10		11		12		
5													
6	10		17		16		15		14		13		
7													
8	19		20		21		22		23		24		
9													
10	30		29		28		27		26		25		
11													
12	31		32		33		34		35		36		
13													

A. Description of original monument and accessories and/or subsequent restoration:

L-13 GLO Notes - Beech 22 N67E 40; Hemlock 14 N61W 29  
Old Survey Liber - None  
L.C.R.C. - None  
Act 132 - Liber 3, Page 177 (CASE)  
Liber 4, Page 365 (CASE)  
Road Comm - None

B. Description of corner evidence found and/or method applied in restoring or reestablishing corner:

L - 13  
S 1/4 Corner Section 36 T14N-R12E  
Found 5/8" Iron Bar in Gravel Road Bed  
West 2642.32 feet to the SW Corner Section 36  
East 2621.60 feet to the SE Corner Section 36  
Accepted as best evidence

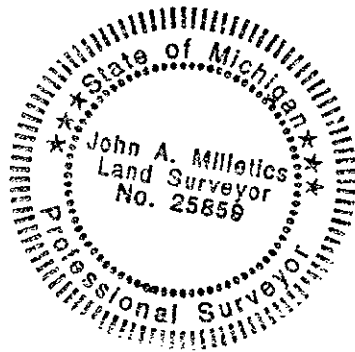

APPROVED PEER BOARD MEETING  
NOV 30, 1998

C. Description of monument for corner and accessories established to perpetuate locating the position of the corner:

L - 13  
S 1/4 Corner Section 36 T14N-R12E  
5/8" Iron Bar in gravel Road  
West 2642.32 feet to the SW Corner Section 36  
East 2621.60 feet to the SE Corner Section 36  
North 39.80 feet to a Concrete Post  
N10°W 45.10 feet to a nail in a 12" Pine Tree  
North 58.15 feet to a nail in a 12" Pine Tree  
S80°E 46.35 feet to a nail in a 12" Ash Tree

SURVEY &  
REMONUMENTATION

JAN 15 1999

SECTION

Signed by John A. Milletics  
Surveyor's Michigan License No. 25859

Date Nov 20, 1998