

SURVEY & REMONUMENTATION

APR 14 1998

LIBER 2 PAGE 150

RECEIVED FOR RECORD

97 DEC -2 AM 9:08

SECTION

1997 REMONUMENTATION

LAND CORNER RECORDATION CERTIFICATE

Filing Requirement of Act 74, Mich. P.A. 1970

BOOK NO. 2 PAGE NO. 150

ESTHER LEE
REGISTER OF DEEDS
SANILAC CO., MICHIGAN

SURVEY & REMONUMENTATION

JAN 08 1998

SECTION

Register of Deeds Stamp & File Number

For corners in AUSTIN TOWNSHIP

SANILAC

(County)

Located In:

Corner Code #

1. Public Land Survey		T14N R 13E	C9
		T R	
		T R	
		T R	
		T R	
2. Property Controlling in Section	S	T R	
	S	T R	
3. Miscellaneous Property in Sec.	S	T R	
	S	T R	

4. Lot No. _____, Recorded Plat _____

5. Private Claims _____

I, John A. Milletics, in a field survey on Oct. 14, 1997 do hereby state that under requirements of P.A. 74, Michigan P.A. of 1970, the corner points mentioned in lines 1 and 2 above were in conformance with regulations and rules therefore as required in the current manual of survey instructions of the United States Department of the Interior, Bureau of Land Management or by a decree of a Court of Law and/or that the corner points mentioned in lines 3, 4 and 5 above were in conformance with the rules of the Michigan Board of Land Surveyors or by a Decree of a Court of Law; established, re-established, monumented, recovered, found as expressed below:

NOTE: Not more than 2 corners, all in the same town and range, may be recorded on this certificate.


A	B	C	D	E	F	G	H	I	J	K	L	M
1												
2	6	5	4	3	2	1						
3												
4	7	8	9	10	11	12						
5												
6	18	17	16	15	14	13						
7												
8	19	20	21	22	23	24						
9												
10	30	29	28	27	26	25						
11												
12	31	32	33	34	35	36						
13												

A. Description of original monument and accessories and/or subsequent restoration:

C9
G.L.O. Notes Set Post Corner Sections 19, 20, 29, and 30
Hemlock 18 S89E 14 Beech 18 S34W 10
Act 74 Form - None
Act 132 Form - None
Road Commission Record - None
Drain Commission Record - None

B. Description of corner evidence found and/or method applied in restoring or reestablishing corner:

C9
Found 5/8" Re-Rod in Monument Box

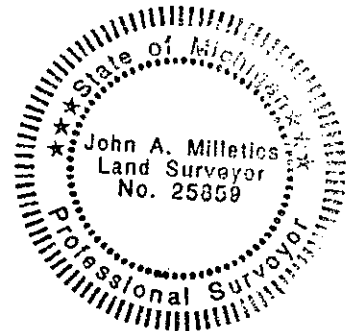

C. Description of monument for corner and accessories established to perpetuate locating the position of the corner:

C9
Corner Sections 19, 20, 29 and 30, T14N-R13E
Found 5/8" Re-Rod in Monument Box
WITNESSES:
N50°E 85.05' to Spike in S.E. Side P.P.
N45°W 58.42' to Spike in S.W. Side Utility Pole
S40°W 63.75' to P.K. Nail in 5' Concrete Sidewalk
S45°E 59.58' to Center of Westerly 5/8" Re-Rod in Trinangular Concrete Monument
South 2643.06' to C10, T14N-R13E
North 2653.82' to 1/2" Re-Rod apparent C8, T14N-R13E

Signed by John A. Milletics
Surveyor's Michigan License No. 25859

Date Nov 12, 1997

PEER GROUP APPROVED
AT MEETING HELD

NOV. 26 1997