

SURVEY & REMONUMENTATION

APR 14 1998

LIBER 2 PAGE 151

RECEIVED FOR RECORD

97 DEC -2 AM 9:08

SECTION

1997 REMONUMENTATION LAND CORNER RECORDATION CERTIFICATE Filing Requirement of Act 74, Mich. P.A. 1970

LIBER NO. 2 PAGE NO. 151

ESTHER LEE REGISTER OF DEEDS SANILAC CO., MICHIGAN

For corners in AUSTIN TOWNSHIP

Table with columns: SANILAC (County), Located in:, Corner Code #. Rows include Public Land Survey, Property Controlling in Section, and Miscellaneous Property in Sec.

SURVEY & REMONUMENTATION

JAN 08 1998

SECTION

Register of Deeds Stamp & File Number

4. Lot No. Recorded Plat
5. Private Claims

I, John A. Millettics in a field survey on Oct. 4, 1997 do hereby state that under requirements of P.A. 74, Michigan P.A. of 1970, the corner points mentioned in lines 1 and 2 above were in conformance with regulations and rules therefore as required in the current manual of survey instructions of the United States Department of the Interior, Bureau of Land Management or by a decree of a Court of Law and/or that the corner points mentioned in lines 3, 4 and 5 above were in conformance with the rules of the Michigan Board of Land Surveyors or by a Decree of a Court of Law; established, re-established, monumented, recovered, found as expressed below:

NOTE: Not more than 2 corners, all in the same town and range, may be recorded on this certificate.

Grid table with columns A-L and rows 1-13. Contains numerical data points for survey locations.

A. Description of original monument and accessories and/or subsequent restoration:


C11
G.L.O. Notes set post cor. Sec's. 29, 30, 31 & 32
Beech 12 S30E 13, Hemlock 18 N36W 32
Act 74 Form - None
Act 132 Form - None
Road Commission Record - None
Drain Commission Record - None

C10
G.L.O. Notes Set 1/4 Section Post
Hemlock 10 S34E 4 Birch 10 N51W 19
Act 74 Form - None
Act 132 Form - None
Road Commission Record - None
Drain Commission Record - None

B. Description of corner evidence found and/or method applied in restoring or reestablishing corner:

C11
Found 1/2" Re-Rod in Monument Box

C10
Found 1/2" Re-Rod in Monument Box

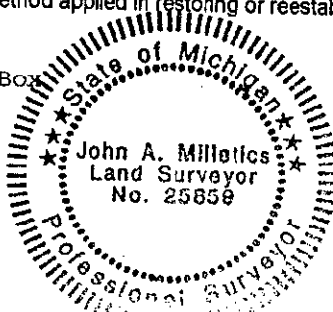

C. Description of monument for corner and accessories established to perpetuate locating the position of the corner:

C11
Cor. Sec's. 29, 30, 31 and 32, T14N-R13E
Found 1/2" Re-Rod in Monument Box
WITNESSES:
N70°E 75.94' to P.K. Nail in N.W. Side Tel.
Ped Post
S45°E 37.48' to 1/2" Steel Stake
S45°W 52.37' to 1/2" Steel Stake
N45°W 69.47' to Spike in N.E. Side P.P.
North 2649.66' C10, T14N-R13E
South 2650.28' 1/2" Re-rod apparent C12, T14N-R13E

C10
1/4 Cor. Sec's. 29 and 30, T14N-R13E
Found 1/2" Re-Rod in Monument Box
WITNESSES:
East 57.15' to Spike in N. Side P.P.
S40°E 40.85' to 1/2" Steel Stake
West 49.40' to P.K. Nail S. Side Cor. Post
N40°W 40.82' to 1/2" Steel Stake
North 2643.06' C9, T14N-R13E
South 2649.66' C11, T14N-R13E

Signed by [Signature]

Date Nov 12, 1997

Surveyor's Michigan License No. 25859

PEER GROUP APPROVED AT MEETING HELD

NOV. 26 1997.