

98 DEC -1 AM 9:09

REMONUMENTATION

LAND CORNER RECORDATION CERTIFICATE
Filing Requirement of Act 74, Mich. P.A. 1970

BOOK NO. 2 PAGE NO. 245

MICHELE VANNORMAN
REGISTER OF DEEDS
SANILAC CO., MICHIGAN

For corners in

Sanilac
(County)

Located In:

Corner Code #

1. Public Land Survey

T14N R15E A-13

T R

T R

T R

2. Property Controlling in Section

S T R

S T R

3. Miscellaneous Property in Sec.

S T R

S T R

Register of Deeds Stamp & File Number

4. Lot No. _____, Recorded Plat _____
5. Private Claims _____

I, John A. Milletics, in a field survey on Oct 17, 1998 do hereby state that under requirements of P.A. 74, Michigan P.A. of 1970, the corner points mentioned in lines 1 and 2 above were in conformance with regulations and rules therefore as required in the current manual of survey instructions of the United States Department of the Interior, Bureau of Land Management or by a decree of a Court of Law and /or that the corner points mentioned in lines 3, 4 and 5 above were in conformance with the rules of the Michigan Board of Land Surveyors or by a Decree of a Court of Law; established, re-established, monumented, recovered, found as expressed below:

NOTE: Not more than 2 corners, all in the same town and range, may be recorded on this certificate.


A	B	C	D	E	F	G	H	I	J	K	L	M
1												
2	6	5	4	3	2	1						
3												
4	7	8	9	10	11	12						
5												
6	18	17	16	15	14	13						
7												
8	19	20	21	22	23	24						
9												
10	30	29	28	27	26	25						
11												
12	31	32	33	34	35	36						
13												

A. Description of original monument and accessories and/or subsequent restoration:

A-13 GLO Notes - Hemlock 18 S3W 1.90; Aspen 10 N10W 85; **SURVEY & REMONUMENTATION**
Aspen 6 S86E 9; Hemlock 15 N29E
Old Survey Liber - None
Road Comm - None
Act 132 - None
Unrecorded survey dated: 10-26-86
L.C.R.C. - None

JAN 15 1999

SECTION

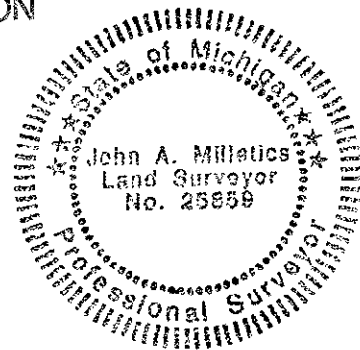

B. Description of corner evidence found and/or method applied in restoring or reestablishing corner:

A - 13
SW Corner Section 31 T14N-R15E
Found 1" Iron Bar in Gravel Road Bed
Accepted as best evidence
East 2372.38 feet to the S 1/4 Corner Section 31

APPROVED PEER BOARD MEETING
NOV 30, 1998

gm

C. Description of monument for corner and accessories established to perpetuate locating the position of the corner:

A - 13
SW Corner Section 31 T14N-R15E
1" Iron bar
N45°W 55.00 feet to a nail in a Power Pole
N75°E 57.40 feet to a Stop Sign
S80°W 48.40 feet to a Stop Sign
N30°W 53.10 feet to the west end of a 12" CMP
N30°E 55.30 feet to the east end of a 12" CMP
East 2372.38 feet to the S 1/4 Corner Section 31

Signed by *John A. Milletics*
Surveyor's Michigan License No. 25859

Date Nov 19, 98