

RECEIVED FOR RECORD

98 DEC -1 AM 9:09

LIBER NO. 2 PAGE NO. 246

REMONUMENTATION

LAND CORNER RECORDATION CERTIFICATE
Filing Requirement of Act 74, Mich. P.A. 1970

MICHELE VANNORMAN
REGISTER OF DEEDS
SANILAC CO., MICHIGAN

For corners in

Sanilac (County)	Located In:	Corner Code #
1. Public Land Survey	T14N R15E	B-13
	T R	
	T R	
	T R	
2. Property Controlling in Section	S T R	
	S T R	
3. Miscellaneous Property in Sec.	S T R	
	S T R	

Register of Deeds Stamp & File Number

4. Lot No. _____, Recorded Plat _____
5. Private Claims _____

I, John A. Milletics, in a field survey on Oct 19, 1998 do hereby state that under requirements of P.A. 74, Michigan P.A. of 1970, the corner points mentioned in lines 1 and 2 above were in conformance with regulations and rules therefore as required in the current manual of survey instructions of the United States Department of the Interior, Bureau of Land Management or by a decree of a Court of Law and /or that the corner points mentioned in lines 3, 4 and 5 above were in conformance with the rules of the Michigan Board of Land Surveyors or by a Decree of a Court of Law; established, re-established, monumented, recovered, found as expressed below:

NOTE: Not more than 2 corners, all in the same town and range, may be recorded on this certificate.

	A	B	C	D	E	F	G	H	I	J	K	L	M
1													
2	6		5		4		3		2		1		
3													
4	7		8		9		10		11		12		
5													
6	13		17		16		15		14		13		
7													
8	19		20		21		22		23		24		
9													
10	30		29		28		27		26		25		
11													
12	31		32		33		34		35		36		
13													


A. Description of original monument and accessories and/or subsequent restoration:

- B-13 GLO Notes - Sugar 12 N76E 40; Beech 12 N53W 30
- Old Survey Liber - None
- L.C.R.C. - None
- Act 132 - None
- Road Comm - None

SURVEY & REMONUMENTATION

JAN 15 1999

SECTION

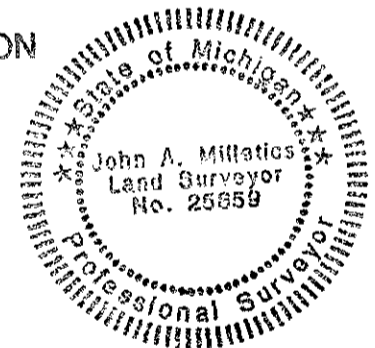

B. Description of corner evidence found and/or method applied in restoring or reestablishing corner:

- B - 13
- S 1/4 Corner Section 31 T14N-R15E
- Set 1/2" Iron Bar at a Proportional distance between the Found SW and SE Corners of Section 31

APPROVED PEER BOARD MEETING
NOV 30, 1998

C. Description of monument for corner and accessories established to perpetuate locating the position of the corner:

- B - 13
- S 1/4 Corner Section 31 T14N-R15E
- 1/2" Iron Bar with cap
- East 2632.32 feet to the SE Corner Section 31
- West 2372.38 feet to the SW Corner Section 31
- East 42.30 feet to a large rock in the Road Bed
- S20°W 36.25 feet to a Bell Box
- N55°E 81.20 feet to a nail in a 8" Ash
- N60°E 46.30 feet to the West leg of a Road Sign

Signed by John A. Milletics
Surveyor's Michigan License No. 25859

Date Nov 19, 98