

98 DEC -1 AM 9:09

LIBER NO. 2 PAGE NO. 247

REMONUMENTATION

LAND CORNER RECORDATION CERTIFICATE
Filing Requirement of Act 74, Mich. P.A. 1970

For corners in

Sanilac (County)	Located In:	Corner Code #
1. Public Land Survey	T14N R15E	C-13
	T R	
	T R	
	T R	
2. Property Controlling in Section	S T R	
	S T R	
3. Miscellaneous Property in Sec.	S T R	
	S T R	

MICHELE VAN NORMAN
REGISTER OF DEEDS
SANILAC CO., MICHIGAN

Register of Deeds Stamp & File Number

4. Lot No. _____, Recorded Plat _____
5. Private Claims _____

I, John A. Milletics, in a field survey on Oct 19, 19 98 do hereby state that under requirements of P.A. 74, Michigan P.A. of 1970, the corner points mentioned in lines 1 and 2 above were in conformance with regulations and rules therefore as required in the current manual of survey instructions of the United States Department of the Interior, Bureau of Land Management or by a decree of a Court of Law and/or that the corner points mentioned in lines 3, 4 and 5 above were in conformance with the rules of the Michigan Board of Land Surveyors or by a Decree of a Court of Law; established, re-established, monumented, recovered, found as expressed below:

	A	B	C	D	E	F	G	H	I	J	K	L	M
1													
2	6		5		4		3		2		1		
3													
4	7		8		9		10		11		12		
5													
6	10		17		16		15		14		13		
7													
8	19		20		21		22		23		24		
9													
10	30		29		28		27		26		25		
11													
12	31		32		33		34		35		36		
13													

NOTE: Not more than 2 corners, all in the same town and range, may be recorded on this certificate.

A. Description of original monument and accessories and/or subsequent restoration:

C-13 GLO Notes - Beech 18 N72 1/2W 29; Beech 10 N28 1/2E 30
Old Survey Liber - None
L.C.R.C. - None
Act 132 - None
Unrecorded survey - Dated 10-20-97
State Highway Book page 86


SURVEY &
REMONUMENTATION

JAN 15 1999

SECTION

B. Description of corner evidence found and/or method applied in restoring or reestablishing corner:

C - 13
SE Corner Section 31 T14N-R15E
Found 1" Iron Bar in gravel road bed
Accepted as best evidence

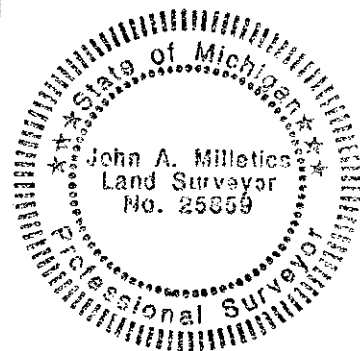

APPROVED PEER BOARD MEETING
NOV 30, 1998

97

C. Description of monument for corner and accessories established to perpetuate locating the position of the corner:

C- 13
SE Corner Section 31 T14N-R15E
1" Iron Bar
East 40.26 feet to a 5/8' Iron Bar in Road Bed
East 81.95 feet to the centerline of pavement
West 2632.32 feet to the S 1/4 Corner Section 31
East 2638.00 feet to the S 1/4 Corner Section 32
N40°W 86.00 feet to a nail in a Power Pole
S70°W 103.55 feet to a R/W Marker

Signed by John A. Milletics
Surveyor's Michigan License No. 25859

Date Nov 19, 98