

REMONUMENTATION

LAND CORNER RECORDATION CERTIFICATE
Filing Requirement of Act 74, Mich. P.A. 1970

98 DEC -1 AM 9:09

LIBER NO. 2 PAGE NO. 248

For corners in

Sanilac (County)	Located In:	Corner Code #
1. Public Land Survey	T14N R15E	D-13
	T___ R___	_____
	T___ R___	_____
	T___ R___	_____
2. Property Controlling in Section	S___ T___ R___	_____
	S___ T___ R___	_____
3. Miscellaneous Property in Sec.	S___ T___ R___	_____
	S___ T___ R___	_____

MICHELE VAN NORMAN
REGISTER OF DEEDS
SANILAC CO., MICHIGAN

Register of Deeds Stamp & File Number

4. Lot No. _____, Recorded Plat _____
5. Private Claims _____

I, John A. Milletics, in a field survey on Oct 19, 1998 do hereby state that under requirements of P.A. 74, Michigan P.A. of 1970, the corner points mentioned in lines 1 and 2 above were in conformance with regulations and rules therefore as required in the current manual of survey instructions of the United States Department of the Interior, Bureau of Land Management or by a decree of a Court of Law and/or that the corner points mentioned in lines 3, 4 and 5 above were in conformance with the rules of the Michigan Board of Land Surveyors or by a Decree of a Court of Law; established, re-established, monumented, recovered, found as expressed below:

NOTE: Not more than 2 corners, all in the same town and range, may be recorded on this certificate.

	A	B	C	D	E	F	G	H	I	J	K	L	M
1													
2	6		5		4		3		2		1		
3													
4	7		8		9		10		11		12		
5													
6	19		17		16		15		14		13		
7													
8	19		20		21		22		23		24		
9													
10	30		29		28		27		26		25		
11													
12	31		32		33		34		35		36		
13													

A. Description of original monument and accessories and/or subsequent restoration:

- D-13 GLO Notes - Maple 10 N40E 10; Beech 10 N41 1/2W 32
- Old Survey Liber - None
- State Highway Book - Page 86
- L.C.R.C. - None
- Road Comm - None
- Act 132 - None
- Unrecorded Survey - Dated 10-20-97, Dated 3-22-95


SURVEY &
REMONUMENTATION

JAN 15 1999

SECTION

B. Description of corner evidence found and/or method applied in restoring or reestablishing corner:

- D-13
- S 1/4 Corner Section 32 T14N-R15E
- Found 1/2" Iron bar in gravel road bed
- Accepted as best evidence
- West 2638.00 feet to the SW Corner Section 32
- East 2651.50 feet to the SE Corner Section 32

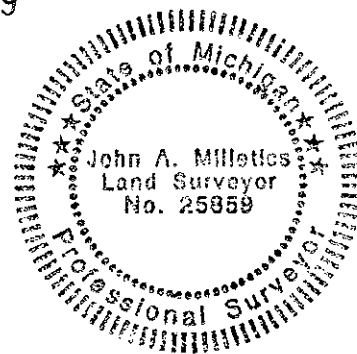

APPROVED PEER BOARD MEETING
NOV 30, 1998

97

C. Description of monument for corner and accessories established to perpetuate locating the position of the corner:

- D-13
- S 1/4 Corner Section 32 T14N-R15E
- 1/2" Iron Bar with cap
- North 33.00 feet to a 1/2" Iron Bar
- West 2638.00 feet to the SW Corner Section 32
- East 2651.50 feet to the SE Corner Section 32
- S40°E 83.00 feet to a nail in a Power Pole

Signed by John A. Milletics
Surveyor's Michigan License No. 25859

Date Nov 19, 98