

RECEIVED FOR RECORD

98 DEC -1 AM 9:09

LIBER NO. 2 PAGE NO. 251

REMONUMENTATION

LAND CORNER RECORDATION CERTIFICATE
Filing Requirement of Act 74, Mich. P.A. 1970

For corners in

Sanilac
(County)

Located in:

Corner Code #

- 1. Public Land Survey T14N R15E G-13
 T R
 T R
 T R
- 2. Property Controlling S T R
 in Section S T R
- 3. Miscellaneous S T R
 Property in Sec. S T R

MICHELE VANNORMAN
REGISTER OF DEEDS
SANILAC CO., MICHIGAN

Register of Deeds Stamp & File Number

- 4. Lot No. _____, Recorded Plat _____
- 5. Private Claims _____

I, John A. Millettics, in a field survey on Oct 19, 1998 do hereby state that under requirements of P.A. 74, Michigan P.A. of 1970, the corner points mentioned in lines 1 and 2 above were in conformance with regulations and rules therefore as required in the current manual of survey instructions of the United States Department of the Interior, Bureau of Land Management or by a decree of a Court of Law and/or that the corner points mentioned in lines 3, 4 and 5 above were in conformance with the rules of the Michigan Board of Land Surveyors or by a Decree of a Court of Law; established, re-established, monumented, recovered, found as expressed below:

NOTE: Not more than 2 corners, all in the same town and range, may be recorded on this certificate.

	A	B	C	D	E	F	G	H	I	J	K	L	M
1													
2	6		5		4		3		2		1		
3													
4	7		8		9		10		11		12		
5													
6	18		17		16		15		14		13		
7													
8	19		20		21		22		23		24		
9													
10	30		29		28		27		26		25		
11													
12	31		32		33		34		35		36		
13													


A. Description of original monument and accessories and/or subsequent restoration:

- G-13 GLO Notes - Hemlock 11 N69W 16; Maple 15 N37E 37
- Old Survey Liber - None
- L.C.R.C.-None
- Act 132 - None
- Road Comm - None
- Old Witnesses from Choqe witnesses book

SURVEY &
REMONUMENTATION

JAN 15 1999

SECTION

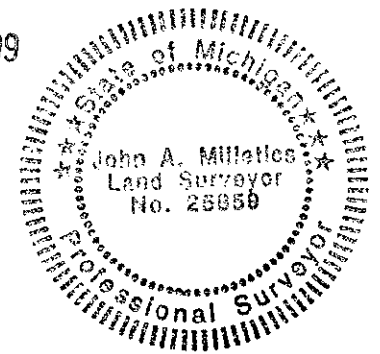

B. Description of corner evidence found and/or method applied in restoring or reestablishing corner:

- G - 13
- SE Corner Section 33 T14N-R15E
- Found 5/8" Iron Bar in Gravel Road Bed
- Accepted as best evidence

APPROVED PEER BOARD MEETING
NOV 30, 1998

C. Description of monument for corner and accessories established to perpetuate locating the position of the corner:

- G - 13
- SE Corner Section 33 T14N-R15E
- 5/8" Iron Bar
- West 2657.94 feet to the S 1/4 Corner Section 33
- East 2678.08 feet to the S 1/4 Corner Section 34
- N15°W 37.30 feet to a Stop Sign
- N40°E 42.70 feet to a Bell Box
- S45°E 59.50 feet to a Stop Sign

Signed by John A. Millettics
Surveyor's Michigan License No. 25859

Date Nov 21, 98