

RECEIVED FOR RECORD

98 DEC -1 AM 9:09

LIBER NO. 2 PAGE NO. 252

REMONUMENTATION

LAND CORNER RECORDATION CERTIFICATE
Filing Requirement of Act 74, Mich. P.A. 1970

For corners in

Sanilac (County)	Located in:	Corner Code #
1. Public Land Survey	T14N R15E	H-13
	T R	
	T R	
	T R	
2. Property Controlling in Section	S T R	
	S T R	
3. Miscellaneous Property in Sec.	S T R	
	S T R	

MICHELE VANNORMAN
REGISTER OF DEEDS
SANILAC CO., MICHIGAN

Register of Deeds Stamp & File Number

4. Lot No. _____, Recorded Plat _____
5. Private Claims _____

I, John A. Millettics, in a field survey on Oct 19, 1998 do hereby state that under requirements of P.A. 74, Michigan P.A. of 1970, the corner points mentioned in lines 1 and 2 above were in conformance with regulations and rules therefore as required in the current manual of survey instructions of the United States Department of the Interior, Bureau of Land Management or by a decree of a Court of Law and/or that the corner points mentioned in lines 3, 4 and 5 above were in conformance with the rules of the Michigan Board of Land Surveyors or by a Decree of a Court of Law; established, re-established, monumented, recovered, found as expressed below:

NOTE: Not more than 2 corners, all in the same town and range, may be recorded on this certificate.

	A	B	C	D	E	F	G	H	I	J	K	L	M
1													
2	6		5		4		3		2		1		
3													
4	7		8		9		10		11		12		
5													
6	18		17		16		15		14		13		
7													
8	19		20		21		22		23		24		
9													
10	30		29		28		27		26		25		
11													
12	31		32		33		34		35		36		
13													


A. Description of original monument and accessories and/or subsequent restoration:

H-13 GLO Notes - Beech 12 N40E 38; Sugar 7 N65W 14
Old Survey Liber - None
L.C.R.C. - None
Act 132 - None
Road Comm - None

SURVEY &
REMONUMENTATION

JAN 15 1999

SECTION

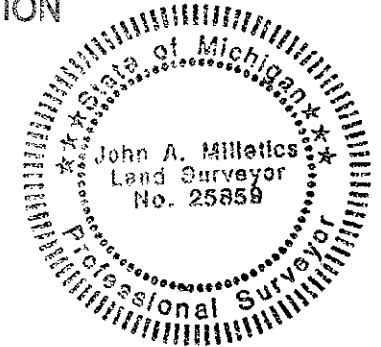

B. Description of corner evidence found and/or method applied in restoring or reestablishing corner:

H - 13
S 1/4 Corner Section 34 T14N-R15E
Set 1/2" Iron bar with cap in line halfway
between SE cor and SW cor of Section

APPROVED PEER BOARD MEETING
NOV 30, 1998

gm

C. Description of monument for corner and accessories established to perpetuate locating the position of the corner:

H - 13
S 1/4 Corner Section 34 T14N-R15E
1/2" Iron Bar with cap
West 2678.08 feet to the SW Corner Section 34
East 2678.08 feet to the SE Corner Section 34
N70°E 44.00 feet to the North end of a CMP
S70°E 45.60 feet to the South end of a CMP
S50°E 151.00 feet to a nail in a Wooden Fence Post

Signed by John A. Millettics
Surveyor's Michigan License No. 25859

Date Nov 21, 98