

98 DEC -1 AM 9:09

LIBER NO. 2 PAGE NO. 253

REMONUMENTATION

LAND CORNER RECORDATION CERTIFICATE
Filing Requirement of Act 74, Mich. P.A. 1970

MICHELE VAN NORMAN
REGISTER OF DEEDS
SANILAC CO., MICHIGAN

For corners in

Sanilac (County)	Located in:	Corner Code #
1. Public Land Survey	T14N R15E	I-13
	T___ R___	_____
	T___ R___	_____
	T___ R___	_____
2. Property Controlling in Section	S___ T___ R___	_____
	S___ T___ R___	_____
3. Miscellaneous Property in Sec.	S___ T___ R___	_____
	S___ T___ R___	_____

Register of Deeds Stamp & File Number

4. Lot No. _____, Recorded Plat _____
5. Private Claims _____

I, John A. Milletics, in a field survey on Oct 19, 1998 do hereby state that under requirements of P.A. 74, Michigan P.A. of 1970, the corner points mentioned in lines 1 and 2 above were in conformance with regulations and rules therefore as required in the current manual of survey instructions of the United States Department of the Interior, Bureau of Land Management or by a decree of a Court of Law and/or that the corner points mentioned in lines 3, 4 and 5 above were in conformance with the rules of the Michigan Board of Land Surveyors or by a Decree of a Court of Law; established, re-established, monumented, recovered, found as expressed below:

NOTE: Not more than 2 corners, all in the same town and range, may be recorded on this certificate.

	A	B	C	D	E	F	G	H	I	J	K	L	M
1													
2	6		5		4		3		2		1		
3													
4	7		8		9		10		11		12		
5													
6	10		17		16		15		14		13		
7													
8	19		20		21		22		23		24		
9													
10	30		29		28		27		26		25		
11													
12	31		32		33		34		35		36		
13													


A. Description of original monument and accessories and/or subsequent restoration:

I-13 GLO Notes - Beech 14 N18W 28; Sugar 10 N54 1/2E
Old Survey Liber - None
L.C.R.C. - None
Act 132 - None
Road Comm - None
Unrecorded survey dated 8-9-81

SURVEY &
REMONUMENTATION

JAN 15 1999

SECTION

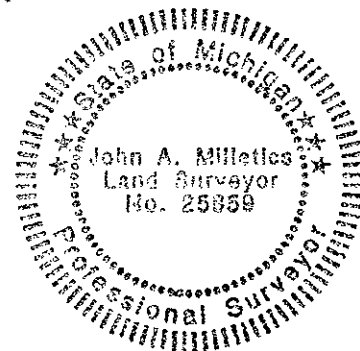

B. Description of corner evidence found and/or method applied in restoring or reestablishing corner:

I - 13
SE Corner Section 34 T14N-R15E
Found 1/2 " Iron Bar 24.42 feet east of a 1/2" Iron Bar
being the NW of Section 2 T13N-R15E
Accepted as best evidence

APPROVED PEER BOARD MEETING
NOV 30, 1998

97

C. Description of monument for corner and accessories established to perpetuate locating the position of the corner:

I - 13
SE Corner Section 34 T14N-R15E
West 24.00 feet to the centerline of a gravel road
West 24.42 feet to a 1/2" Iron Bar
N45°E 60.00 feet to a nail in a Power Pole
N70°W 92.70 feet to a nail in a Power Pole
S10°E 30.85 feet to a Bell Box
S30°E 41.50 feet to a Bell Box
West 2678.08 feet to the S 1/4 Corner Section 34
East 2632.38 feet to the S 1/4 Corner Section 35

Signed by John A. Milletics
Surveyor's Michigan License No. 25859

Date Nov 20, 98