

RECEIVED FOR RECORD

98 DEC -1 AM 9:09

LIBER NO. 2 PAGE NO. 254

REMONUMENTATION

LAND CORNER RECORDATION CERTIFICATE
Filing Requirement of Act 74, Mich. P.A. 1970

MICHELE VAN NORMAN
REGISTER OF DEEDS
SANILAC CO., MICHIGAN

For corners in

Sanilac
(County)

Located in:

Corner Code #

1. Public Land Survey

T14N R15E J-13

T R

T R

T R

2. Property Controlling
in Section

S T R

S T R

3. Miscellaneous
Property in Sec.

S T R

S T R

Register of Deeds Stamp & File Number

4. Lot No. _____, Recorded Plat _____

5. Private Claims _____

I, John A. Millettics, in a field survey on Oct 19, 1998 do hereby state that under requirements of P.A. 74, Michigan P.A. of 1970, the corner points mentioned in lines 1 and 2 above were in conformance with regulations and rules therefore as required in the current manual of survey instructions of the United States Department of the Interior, Bureau of Land Management or by a decree of a Court of Law and/or that the corner points mentioned in lines 3, 4 and 5 above were in conformance with the rules of the Michigan Board of Land Surveyors or by a Decree of a Court of Law; established, re-established, monumented, recovered, found as expressed below:

NOTE: Not more than 2 corners, all in the same town and range, may be recorded on this certificate.

	A	B	C	D	E	F	G	H	I	J	K	L	M
1													
2	6		5		4		3		2		1		
3													
4	7		8		9		10		11		12		
5													
6	18		17		16		15		14		13		
7													
8	19		20		21		22		23		24		
9													
10	30		29		28		27		26		25		
11													
12	31		32		33		34		35		36		
13													


A. Description of original monument and accessories and/or subsequent restoration:

J-13 GLO Notes - Sugar 9 N87E 29; Hemlock 15 N66 25
Old Survey Liber - None
L.C.R.C. - None
Act 132 - None
Road Comm - None
Unrecorded survey dated 8-9-91

SURVEY &
REMONUMENTATION

JAN 15 1999

SECTION

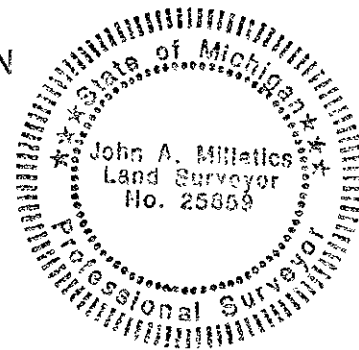

B. Description of corner evidence found and/or method applied in restoring or reestablishing corner:

J - 13
S 1/4 Corner Section 35 T14N-R15E
Set 1/2" Iron Bar with cap on line between the SE Corner and SW corner of Section at half distance.

APPROVED PEER BOARD MEETING
NOV 30, 1998

C. Description of monument for corner and accessories established to perpetuate locating the position of the corner:

J- 13
S 1/4 Corner Section 35 T14N-R15E
1/2 " Iron Bar
West 2632.38 feet to the SW Corner Section 35 T14N-R15E
East 2632.38 feet to the SE Corner Section 35 T14N-R15E
N80°W 59.95 feet to a nail in a Wooden Fence Post
South 2.00 feet to the centerline of a gravel road
S45°W 35.00 feet to a 1/2" iron bar
S45°E 35.00 feet to a 1/2" iron bar

Signed by John A. Millettics
Surveyor's Michigan License No. 25859

Date Nov 20, 98