

RECEIVED FOR RECORD

98 DEC -1 AM 9:09

LIBER NO. 2 PAGE NO. 255

REMONUMENTATION

LAND CORNER RECORDATION CERTIFICATE

Filing Requirement of Act 74, Mich. P.A. 1970

For corners in

Sanilac (County)	Located in:	Corner Code #
1. Public Land Survey	T14N R15E	K-13
	T R	
	T R	
	T R	
2. Property Controlling in Section	S T R	
	S T R	
3. Miscellaneous Property in Sec.	S T R	
	S T R	

MICHELE VANNORMAN  
REGISTER OF DEEDS  
SANILAC CO., MICHIGAN

Register of Deeds Stamp & File Number

4. Lot No. \_\_\_\_\_, Recorded Plat \_\_\_\_\_  
5. Private Claims \_\_\_\_\_

I, John A. Milletics, in a field survey on Oct 19, 19 98 do hereby state that under requirements of P.A. 74, Michigan P.A. of 1970, the corner points mentioned in lines 1 and 2 above were in conformance with regulations and rules therefore as required in the current manual of survey instructions of the United States Department of the Interior, Bureau of Land Management or by a decree of a Court of Law and/or that the corner points mentioned in lines 3, 4 and 5 above were in conformance with the rules of the Michigan Board of Land Surveyors or by a Decree of a Court of Law; established, re-established, monumented, recovered, found as expressed below:

NOTE: Not more than 2 corners, all in the same town and range, may be recorded on this certificate.

	A	B	C	D	E	F	G	H	I	J	K	L	M
1													
2	6		5		4		3		2		1		
3													
4	7		8		9		10		11		12		
5													
6	18		17		16		15		14		13		
7													
8	19		20		21		22		23		24		
9													
10	30		29		28		27		26		25		
11													
12	31		32		33		34		35		36		
13													


A. Description of original monument and accessories and/or subsequent restoration:

K-13 GLO Notes- Beech 11 N65 1/2E 32; Beech 9 N44W 27  
Old Survey Liber - M.E. Ward Dated 1891  
L.C.R.C. - None  
Act 132 - None  
Road Comm - None  
Unrecorded survey dated 8-9-91  
Chope witnesses book

SURVEY & REMONUMENTATION

JAN 15 1999

SECTION

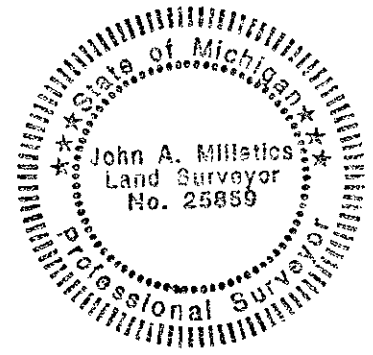

B. Description of corner evidence found and/or method applied in restoring or reestablishing corner:

K - 13  
SE Corner Section 35 T14N-R15E  
Found 5/8" Iron Bar  
Accepted as best evidence

APPROVED PEER BOARD MEETING  
NOV 30, 1998

C. Description of monument for corner and accessories established to perpetuate locating the position of the corner:

K - 13  
SE Corner Section 35 T14N-R15E  
5/8" Iron Bar  
N45°W 76.40 feet to a nail in a Power Pole  
S50°W 64.75 feet to a nail in a Power Pole  
S50°E 59.00 feet to a nail in a Anchor Pole  
West 6.67 feet to a 1" Iron bar in road bed  
West 2632.38 feet to the S 1/4 Corner Section 35  
East 2643.82 feet to the S 1/4 Corner Section 36

Signed by [Signature]  
Surveyor's Michigan License No. 25859

Date Nov 20, 1998