

98 DEC -1 AM 9:09

REMONUMENTATION

LAND CORNER RECORDATION CERTIFICATE
Filing Requirement of Act 74, Mich. P.A. 1970

LIBER NO. 2 PAGE NO. 256

For corners in

Sanilac (County)	Located In:	Corner Code #
1. Public Land Survey	T14N R15E	L-13
	T R	
	T R	
	T R	
2. Property Controlling in Section	S T R	
	S T R	
3. Miscellaneous Property in Sec.	S T R	
	S T R	

MICHELE VANNORMAN
REGISTER OF DEEDS
SANILAC CO., MICHIGAN

Register of Deeds Stamp & File Number

- 4. Lot No. _____, Recorded Plat _____
- 5. Private Claims _____

I, John A. Milletics, in a field survey on Oct 20, 1998 do hereby state that under requirements of P.A. 74, Michigan P.A. of 1970, the corner points mentioned in lines 1 and 2 above were in conformance with regulations and rules therefore as required in the current manual of survey instructions of the United States Department of the Interior, Bureau of Land Management or by a decree of a Court of Law and/or that the corner points mentioned in lines 3, 4 and 5 above were in conformance with the rules of the Michigan Board of Land Surveyors or by a Decree of a Court of Law; established, re-established, monumented, recovered, found as expressed below:

NOTE: Not more than 2 corners, all in the same town and range, may be recorded on this certificate.

A	B	C	D	E	F	G	H	I	J	K	L	M
1												
2	6		5		4		3		2		1	
3												
4	7		8		9		10		11		12	
5												
6	18		17		16		15		14		13	
7												
8	19		20		21		22		23		24	
9												
10	30		29		28		27		26		25	
11												
12	31		32		33		34		35		36	
13												

A. Description of original monument and accessories and/or subsequent restoration:

L-13 GLO Notes - Hemlock 9 N54W 18; Hemlock 11 N83 1/2E 4 1/2
Old Survey Liber - Survey by M.E. Ward dated 1891
L.C.R.C. - None
Act 132 - None
Road Comm - None


SURVEY &
REMONUMENTATION

JAN 15 1999

SECTION

B. Description of corner evidence found and/or method applied in restoring or reestablishing corner:

L -13
S 1/4 Corner Section 36 T14N-R15E
1/2" Iron Bar with cap on line between the SE corner and the SW corner of the section at half distance.

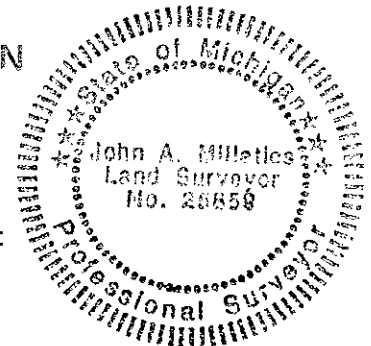

APPROVED PEER BOARD MEETING
NOV 30, 1998

91

C. Description of monument for corner and accessories established to perpetuate locating the position of the corner:

L- 13
S 1/4 Corner Section 36 T14N-R15E
1/2" iron bar with cap
S10°W 41.00 feet to a nail in a 6" Apple tree
N45°W 45.00 feet to the South end of a drain tile
N25°W 33.70 feet to the South end of a drain tile
N50°W 92.20 feet to a nail in a Power Pole
West 2643.82 feet to the SW Corner Section 36
East 2643.82 feet to the Se Corner Section 36

Signed by John A. Milletics
Surveyor's Michigan License No. 25859

Date Nov 20, 98