

REMONUMENTATION

RECEIVED FOR RECORD

LAND CORNER RECORDATION CERTIFICATE
Filing Requirement of Act 74, Mich. P.A. 1970

98 DEC -1 AM 9:09

LIBER NO. 2 PAGE NO. 258

For corners in

Sanilac (County)	Located In:	Corner Code #
1. Public Land Survey	T14N R16E	B-13
	T R	
	T R	
	T R	
2. Property Controlling in Section	S T R	
	S T R	
3. Miscellaneous Property in Sec.	S T R	
	S T R	

MICHELE VANNORMAN
REGISTER OF DEEDS
SANILAC CO., MICHIGAN

Register of Deeds Stamp & File Number

4. Lot No. _____, Recorded Plat _____
5. Private Claims _____

I, John A. Milletics, in a field survey on Oct 20, 1998 do hereby state that under requirements of P.A. 74, Michigan P.A. of 1970, the corner points mentioned in lines 1 and 2 above were in conformance with regulations and rules therefore as required in the current manual of survey instructions of the United States Department of the Interior, Bureau of Land Management or by a decree of a Court of Law and/or that the corner points mentioned in lines 3, 4 and 5 above were in conformance with the rules of the Michigan Board of Land Surveyors or by a Decree of a Court of Law; established, re-established, monumented, recovered, found as expressed below:

NOTE: Not more than 2 corners, all in the same town and range, may be recorded on this certificate.


	A	B	C	D	E	F	G	H	I	J	K	L	M
1													
2	6		5		4		3		2		1		
3													
4	7		8		9		10		11		12		
5													
6	18		17		16		15		14		13		
7													
8	19		20		21		22		23		24		
9													
10	30		29		28		27		26		25		
11													
12	31		32		33		34		35		36		
13													

A. Description of original monument and accessories and/or subsequent restoration:

B-13 GLO Notes - Sugar 16 N49E 27; Beech 7 N76W 21
Old Survey Liber - Survey by J.W Galbraith dates 1893
L.C.R.C. - None
Act 132 - None
Road Comm - None
Unrecorded survey dated 11-21-94

B. Description of corner evidence found and/or method applied in restoring or reestablishing corner:

B- 13
S 1/4 Corner Section 31 T14N-R16E
Set 1/2" Iron bar with cap in line between the SE corner and the SW corner of said section at half distance.

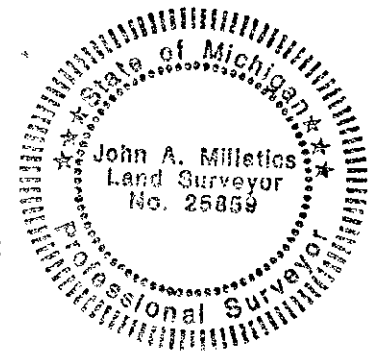

APPROVED PEER BOARD MEETING
NOV 30, 1998

C. Description of monument for corner and accessories established to perpetuate locating the position of the corner:

B- 13
S 1/4 Corner Section 31 T14N-R16E
1/2" Iron Bar with cap
West 2640.10 feet to the SW Corner Section 31
East 2640.10 feet to the SE Corner Section 31
West 8.20 feet to a 1/2" Iron Bar in gravel road bed
N45°E 208.25 feet the a nail in a Power Pole
N60°E 177.90 feet to a buried cable sign
N50°E 75.14 feet to the North end of a CMP
S50°E 78.55 feet to the South end of a CMP

SURVEY &
REMONUMENTATION

JAN 15 1999

SECTION

Signed by John A. Milletics
Surveyor's Michigan License No. 25859

Date Nov 20, 98