

RECEIVED FOR RECORD

98 DEC -1 AM 9: 09

REMONUMENTATION

LAND CORNER RECORDATION CERTIFICATE
Filing Requirement of Act 74, Mich. P.A. 1970

LIBER NO. 2 PAGE NO. 260

For corners in

MICHELE VAN NORMAN
REGISTER OF DEEDS
SANILAC CO., MICHIGAN

Sanilac (County)	Located In:	Corner Code #
1. Public Land Survey	T14N R16E	D-13
	T___ R___	_____
	T___ R___	_____
	T___ R___	_____
2. Property Controlling in Section	S___ T___ R___	_____
	S___ T___ R___	_____
3. Miscellaneous Property in Sec.	S___ T___ R___	_____
	S___ T___ R___	_____

Register of Deeds Stamp & File Number

4. Lot No. _____, Recorded Plat _____
5. Private Claims _____

I, John A. Milletics, in a field survey on Oct 20, 19 98 do hereby state that under requirements of P.A. 74, Michigan P.A. of 1970, the corner points mentioned in lines 1 and 2 above were in conformance with regulations and rules therefore as required in the current manual of survey instructions of the United States Department of the Interior, Bureau of Land Management or by a decree of a Court of Law and /or that the corner points mentioned in lines 3, 4 and 5 above were in conformance with the rules of the Michigan Board of Land Surveyors or by a Decree of a Court of Law; established, re-established, monumented, recovered, found as expressed below:

NOTE: Not more than 2 corners, all in the same town and range, may be recorded on this certificate.


	A	B	C	D	E	F	G	H	I	J	K	L	M
1													
2	6		5		4		3		2		1		
3													
4	7		8		9		10		11		12		
5													
6	18		17		16		15		14		13		
7													
8	19		20		21		22		23		24		
9													
10	30		29		28		27		26		25		
11													
12	31		32		33		34		35		36		
13													

A. Description of original monument and accessories and/or subsequent restoration:

D-13 GLO Notes - Hemlock 20 N65 1/2W 23; Hemlock 24 N39E 26
Old Survey Liber - None
L.C.R.C. - None
Act 132 - None
Road Comm - None
Chope witnesses book

B. Description of corner evidence found and/or method applied in restoring or reestablishing corner:

D -13
S 1/4 Corner Section 32 T14N-R16E
Found 5/8" Iron Bar in gravel road bed
Accepted as best evidence

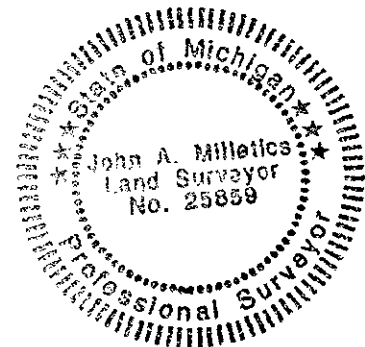

APPROVED PEER BOARD MEETING
NOV 30, 1998 *JM*

C. Description of monument for corner and accessories established to perpetuate locating the position of the corner:

D - 13
S 1/4 Corner Section 32 T14N-R16E
5/8" Iron Bar
N10°E 37.25 feet to a nail in a 18" Pine
N40°W 46.80 feet to a nail in a 18" Pine
West 19.00 feet to a 1" Pipe in road bed
West 2640.20 feet to the SW Corner Section 32

SURVEY &
REMONUMENTATION

JAN 15 1999

SECTION

Signed by *John A. Milletics*
Surveyor's Michigan License No. 25859

Date Nov 20, 1998