

MAR 1 6 1999

ST. CLAIR COUNTY, MICHIGAN OFFICIAL GOVERNMENT CORNER



LAND CORNER RECORDATION CERTIFICATE Filing Requirement of Act 74, Mich. P.A. 1970

SECTION

Located In: Corner Code # Cottrellville Township

Table with 4 columns: Item, T, R, Corner Code #. Row 1: Public Land Survey, T 3N, R 16E, A-1. Row 2: Property Controlling in Section, S, T, R. Row 3: Miscellaneous Property in Sec., S, T, R.

4. Lot. No. Recorded Plat
5. Private Claims

I, John C. Niederhauser, in a field survey on September 22, 1998, do hereby certify that under requirements of P.A. 74, Michigan P.A. of 1970, the corner points mentioned in lines 1 and 2 above were in conformance with regulations and rules therefore as required in the current manual of survey instructions of the United States Department of the Interior, Bureau of Land Management or by a decree of a Court of Law and/or that the corner points mentioned in lines 3, 4 and 5 above were in conformance with the rules of the Michigan Board of Land Surveyors or by a Decree of a Court of Law; established, re-established, monumented, re-monumented, recovered, found as expressed below:

NOTE: Not more than 1 CORNER, may be recorded on this certificate.

A. Description of original monument and accessories and/or subsequent restoration:

Wood post set as original corner by William Preston in May 1817. This is a Township corner and is common to corners M-1 of T3N-R15E, A-13 of T4N-R16E and M-13 of T4N-R15E. Old County Surveyors Records lists corner witnesses but does not describe type of monumentation. Lloyd Thomas recovers and records a P.K. nail, October 1972, see Liber 1, pager 476. John Lansky recovers and records P.K. nail with cap, October 1976, see Liber 3, page 358. Robert Kreger found a 1" pipe and raised with monument box, August 9, 1988, see Liber 6, page 82. Jack Lansky recovers and records a found iron pipe in a monument box February 1997, see Liber 9, page 3.


B. Description of corner evidence found and/or method applied in restoring or reestablishing corner:

Found a 3/4" iron pipe in a monument box on the centerline of pavement of Marine City Highway and the approximate center of Mayer Road (unimproved both north and south). Verified corner using previously recorded witnesses and reference distances on corner certificates: Liber 6, page 82; Liber 9, page 3; and Liber 3, page 358. Measured west to SW corner Section 36 of T4N-R15E, 2,694.54' (R), 2,694.51' (M). Measured south to west 1/4 corner Section 6 of T3N-R16E; 2,685.00' (R), 2,685.02' (M). Measured east to north 1/4 corner Section 6 of T3N-R16E; 2,712.16' (R), 2,712.28' (M).

C. Description of monument for corner and accessories established to perpetuate locating the position of the corner:

Set a 2" diameter aluminum cap with a magnet attached, inscribed "St. Clair County Official Corner", placed on a 1/2" diameter rerod. Both placed over the existing 3/4" diameter pipe in the existing monument box. Located at the GLO Township corner and is common to corners: A-13 of T4N-R16E, M-1 of T3N-R15E and M-13 of T4N-R15E.
N 25°E 84.20' to set P.K. nail with SCC Remon. washer in the NW side of a 12" Elm Tree.
N 25°W 65.13' to set P.K. nail with SCC Remon. washer in SW side of a Utility Pole.
S 65°W 80.34' to set P.K. nail with SCC Remon washer in SE side of Telephone Pole.
S 55°W 40.58' to a cut "X" in top of the east end of the south concrete headwall of box culvert.

Signed by [Signature] Date December 4, 1998
Surveyor's Michigan License No. 24608

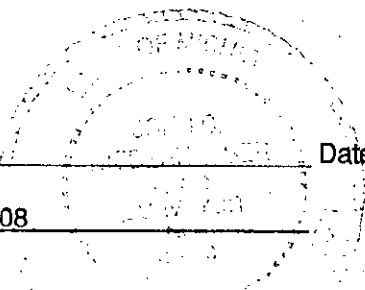

RECEIVED
REGISTER OF DEEDS
ST. CLAIR COUNTY, MICHIGAN
DEC 15 1998

Register of Deeds Stamp & File Number

Grid table with columns A-M and rows 2-13. Cell (2,6) contains a dot.