



# ST. CLAIR COUNTY, MICHIGAN OFFICIAL GOVERNMENT CORNER

LAND CORNER RECORDATION CERTIFICATE  
Filing Requirement of Act 74, Mich. P.A. 1970

RECORDED  
ST. CLAIR COUNTY  
MICHIGAN  
MAY 9 11:10 AM '00  
REGISTERED  
TOWN

Located in: CASCO TOWNSHIP Corner Code # D-1

1. Public Land Survey	T	<u>4N</u>	R	<u>15E</u>	<u>D-1</u>
	T		R		
2. Property Controlling in Section	S		T	R	
	S		T	R	
3. Miscellaneous Property in Sec.	S		T	R	
	S		T	R	

Seg. #2

Register of Deeds Stamp & File Number

4. Lot No. \_\_\_\_\_, Recorded Plat \_\_\_\_\_  
5. Private Claims \_\_\_\_\_

I, MICHAEL J. ROSSOW, in a field survey on AUGUST 5, 1999, do hereby certify that under requirements of P.A. 74, Michigan P.A. of 1970, the corner points mentioned in lines 1 and 2 above were in conformance with regulations and rules therefore as required in the current manual of survey instructions of the United States Department of the Interior, Bureau of Land Management or by a decree of a Court of Law and/or that the corner points mentioned in lines 3, 4 and 5 above were in conformance with the rules of the Michigan Board of Land Surveyors or by a Decree of a Court of Law; established, re-established, monumented, re-monumented, recovered, found as expressed below:

A	B	C	D	E	F	G	H	I	J	K	L	M
2	6	5	4	3	2	1						
3												
4	7	8	9	10	11	12						
5												
6	18	17	16	15	14	13						
7												
8	19	20	21	22	23	24						
9												
10	30	29	28	27	26	25						
11												
12	31	32	33	34	35	36						
13												

**NOTE: Not more than 1 CORNER, may be recorded on this certificate.**


A. Description of original monument and accessories and/or subsequent restoration:

- D-1 NO CORNER SET HERE IN ORIGINAL GOVERNMENT SURVEY.
  - (A) 1974, J. LANSKY LCRC L.2, P.09 & 10 (SET 1/4 CORNER "T" IRON 59.25' EAST OF SOUTH 1/4 CORNER OF SECTION 32, T.5N., R.15E.)
  - (B) 1969, H. KOBBS LCRC L.6, P.172 (RESETS CORNER FROM PREVIOUS WITNESSES AND RECORDED WITNESSES BUT NO REFERENCE AS TO WHICH WITNESSES.)
  - (C) 1990, D. KING LCRC L.6, P.266 (RESETS CORNER FROM PREVIOUS WITNESSES AND RECORDED WITNESSES BUT NO REFERENCE AS TO WHICH WITNESSES.)
  - (D) 1942, OLD ST. CLAIR COUNTY SURVEYORS RECORD (FINDS NO CORNER)
  - (E) ST. CLAIR COUNTY ROAD COMMISSION PLANS 7-07-1993 (R. KREGER)
- \* SEE BACK OF SHEET

B. Description of corner evidence found and/or method applied in restoring or reestablishing corner:

FOUND A 1/2" IRON IN A STD. MONUMENT "T" BOX ON CENTERLINE OF HIGHWAY USING DISTANCES FROM "A" ABOVE AND VERIFIED THE FOLLOWING WITNESSES:

- SOUTH SOUTH WEST 65.60' TO PK IN 24" HICKORY (E)
- SOUTH EAST 82.46' TO SPIKE IN (SW) DETROIT EDISON POLE (E)(M)(N)(O)(G)
- NORTH WEST 62.11' TO PK IN (NE) TELEPHONE POLE (E)(M)
- NORTH WEST 73.86' TO FACE 3.5" STEEL PIPE/MARKER POST (E)
- WEST 59.2' TO SOUTH 1/4 CORNER OF SECTION 32, T.5N., R.15E. (A)(E)(G)
- NORTH WEST 79.0' TO SOUTHEAST CORNER OF RAILROAD TIE FE POST (G)
- SOUTH SOUTH WEST 65.5' NAIL IS IN HICKORY (J)(M)(O)
- 59.2' WEST TO FENCE LINE NORTH (N)

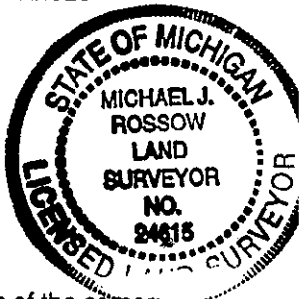

C. Description of monument for corner and accessories established to perpetuate locating the position of the corner:

SET A 2" DIAMETER ALUMINUM CAP WITH MAGNET ATTACHED & INSCRIBED "ST. CLAIR COUNTY OFFICIAL CORNER" ON THE EXISTING 1/2" IRON IN MONUMENT BOX AT THE CLOSING CORNER WHICH LIES 0.52' SOUTH OF AND NORMAL TO A LINE BETWEEN THE SOUTH 1/4 CORNER OF SECTION 32 & THE SOUTH EAST CORNER OF SECTION 32, T.5N., R.15E., & WITNESSED AS FOLLOWS:

- SOUTH EAST 79.63' COUNTY TAG IN POWER POLE
- EAST NORTH EAST 117.29' COUNTY TAG IN GUARD RAIL POST
- NORTH WEST 79.2' COUNTY TAG IN RAILROAD TIE FE POST
- SOUTH SOUTH WEST 65.54' COUNTY TAG IN 15' TREE (HICKORY)

THE SELECTED LOCATION IS ACCEPTED BY ME AND IS GENERALLY ACCEPTED BY PROFESSIONAL SURVEYORS AS THE BEST AVAILABLE EVIDENCE OF THE POSITION OF THE ORIGINAL CORNER.

Signed by

Date 3-27-2000

Surveyor's Michigan License No. 24615

THIS CERTIFICATE RERECORDED TO CORRECT THE "TOWN" DESIGNATION FOR CASCO TWP. (T.4N.)



**ST. CLAIR COUNTY, MICHIGAN  
OFFICIAL GOVERNMENT CORNER**

**LAND CORNER RECORDATION CERTIFICATE  
Filing Requirement of Act 74, Mich. P.A. 1970**

	Located In:	Corner Code #
	<b>CASCO TOWNSHIP</b>	
1. Public Land Survey	T <u>4N</u> R <u>15E</u>	<u>D-1</u>
	T _____ R _____	_____
2. Property Controlling in Section	S _____ T _____ R _____	_____
	S _____ T _____ R _____	_____
3. Miscellaneous Property in Sec.	S _____ T _____ R _____	_____
	S _____ T _____ R _____	_____

Register of Deeds Stamp & File Number

- (F) ST. CLAIR COUNTY ROAD COMMISSION PLANS 07-07-1993 (INSTALLS A MONUMENT BOX OVER FOUND POINT & WITNESSES)
- (A) ST. CLAIR COUNTY ROAD COMMISSION WITNESS BOOK (WITNESSES A 1/2" IRON BAR SET ON LCRC L.6, P.172)
- (B) 1972, C. MELCHING SURVEY L.1, P.194 (IDENTIFIES & WITNESSES A 1 1/2" PIPE AS CORNER)
- (C) 1979, B. COLLINS SURVEY L.1, P.444 (REFERS TO CORNER, DOES NOT IDENTIFY NOR WITNESS)
- (D) 1972, H. KOBBS SURVEY L.1, P.590 (FINDS A 1/2" IRON BAR BY BENT 1 1/2" PIPE & WITNESSES THE SAME)
- (E) 1996, D. KING SURVEY L.15, P.410 (FINDS & WITNESSES A 1/2" IRON BAR)
- (F) 1969, D. KING SURVEY L.11, P.190 (FINDS & WITNESSES A 1/2" IRON BAR)
- (G) 1991, G. JAMES SURVEY L.15, P.379 (REFERS TO F.I. #19635 AS CORNER, NO WITNESSES)
- (H) 1968, B. COLLINS UNRECORDED SURVEY (REFERS TO CORNER, NO ID, NO WITNESSES)
- (I) 1966, R. KREGER SURVEY (FINDS A P.K. NAIL & WITNESSES)
- (J) 1982, W. SODERBERG UNRECORDED SURVEY (FINDS A P.K. NAIL, WITNESSES SAME AND REFERS TO LCRC L.1, P.176)

THIS CERTIFICATE RERECORDED  
TO CORRECT THE "TOWN" DESIGNATIC  
FOR CASCO TWP. (T.4N)